IREDELL COUNTY HEALTH DEPARTMENT

STATESVILLE 704-878-5305 175.00 Paid MOORESVILLE 704-664-5281

IMPROVEMENT PERMIT / AUTHORIZATION TO CONSTRUCT / OPERATION PERMIT / EXISTING SYSTEM INSPECTION

PERMIT# 095482 PIN# 4711-50-3010 DATE 10/5/01

OWNER OR CONTRACTOR Bo & NC Eng PHONE: Business 704 425 1600 Home

ADDRESS 5734 Hwy 150E Denver NC 28037

LOCATION OMR, TL Buffalo Shoals, TL Laurel Cove, TL Highland Terrace on Lt.

SUBDIVISION River Hill Est. BLOCK / SECTION LOT 18 LOT AREA 0.59 AC SITE CLASS PS DESIGN FLOW 360 L.T.A.R. 0.5

Septic Tank: 1000 Gallons; STB 312 Date 9-31-9

Pump Tank: Gallons; PT Date

Pump Make: Model Serial No

Nitrification Field: No Fields 1 Square Feet 900 Linear Feet 300

No Lines 3@100' Trench Width 36" Max Trench Bottom Depth 36" Gravel Depth —

☒ New System ☐ Repair System Type: I II (III) IV V VI

System Description: Gravity 25% Red.

Repair System Description: Panel

Maintenance Agreement Required: ☐ Yes ☒ No

☒ House/Mod. Home No. Bedrooms 3

☐ Mobile Home No. Bathrooms 3

☐ Business No. Employees

☐ Other

☐ Slab ☒ Crawl Space ☐ Basement w/plumbing ☐ Basement wo/plumbing


Water Supply: ☒ Individual ☐ Public ☐ Community

Comments/Conditions:

Comments/Conditions: GM McNally gave prior approval for deeper than 36" System
- 2 Sel Filter Installed
- Septic Tank Marker Installed

1" = 50'

INITIAL SITE SKETCH

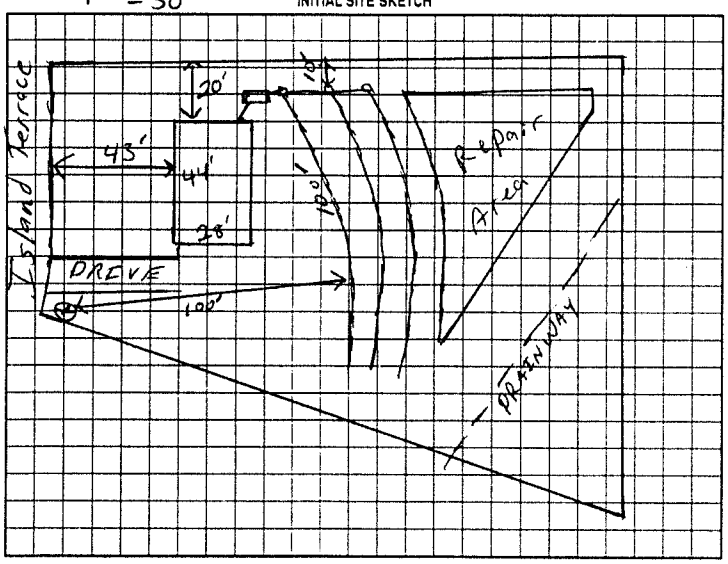

AS BUILT SKETCH

- Fin Cap (Hidden) Section Installed

Installed as Shown

Nitrification Lines Deep!!
2 @ 6" 1st Shot.

Permit can be suspended or revoked if any false information is supplied toward securing the permit/any unauthorized changes are made to the site any unauthorized changes are made in the installation of the system. Improvement Permit with plat valid without expiration. Improvement Permit with site plan valid for sixty months. Authorization to Construct is valid for a period equal to that of Improvement Permit – not to exceed sixty months.

Signed: Duane Faulkner date 10-9-01 Installed by: Tim Ammons

Improvement Permit by: RST date 10/8/01 Operation Permit by: date 11/5/01

Authorization to Construct by: RST date 10/8/01 Existing System Inspection by: date

HEALTH DEPT. COPY: WHITE OWNER COPY (FINAL): YELLOW OWNER COPY (INITIAL): PINK