IREDELL COUNTY HEALTH DEPARTMENT

STATESVILLE 704-878-5305 MOORESVILLE 704-664-5281

IMPROVEMENT PERMIT / AUTHORIZATION TO CONSTRUCT / OPERATION PERMIT / EXISTING SYSTEM INSPECTION

PERMIT# ~~09548~~ 12437 PIN# 4711-50-4019 DATE 7/17/02

OWNER OR CONTRACTOR ~~Bo of NC Inc~~ RONALD TOUCHTON PHONE: Business (704) 489-4663 Home —

ADDRESS 5734 Hwy 150 Denver, N.C. 28037

LOCATION Buffalo Shoals Rd, cross 616 Main Rd, ② on Laurel Cove Road, ① on Wishbone Rd 6th on Left

SUBDIVISION ~~Island Ferry~~ BLOCK / SECTION — LOT 17 LOT AREA .77 Acres SITE CLASS. PS DESIGN FLOW 360 L.T.A.R. .30

Septic Tank: 4000 Gallons; STB 794 Date 11-16-04 ☒ New System ☐ Repair System Type: I, II, (III) IV, V, VI ☒ House/Mod. Home No. Bedrooms 3

Pump Tank: ____ Gallons; PT ____ Date ____ System Description: Gravity, 25% Reduction ☐ Mobile Home No. Bathrooms 2

Pump Make: ____ Model ____ Serial No. ____ Repair System Description: Pump, 50% Reduction ☐ Business No. Employees ____

Nitrification Field: No Fields 1 Square Feet 1300 equiv. to Linear Feet 300' Maintenance Agreement Required: ☐ Yes ☒ No ☐ Other ____


No Lines 3 Trench Width 36" Max Trench Bottom Depth 36" Gravel Depth N/A ☐ Slab ☒ Crawl Space ☐ Basement w/plumbing ☐ Basement wo/plumbing

Water Supply: ☒ Individual ☐ Public ☐ Community

Comments/Conditions: ① Install 25% Reduction System ② maintain proper setbacks

Comments/Conditions: 6-10-04. NEW HOUSE IS 72'x28'. KEEP THE BACK OF THE HOME & STUBOUT IN THE SAME LOCATION SO SYSTEM WILL NOT BE AFFECTED. DRIVEWAY WILL ALSO BE FLIPPED TO THE OPPOSITE SIDE & FRONT ENTRY.

INITIAL SITE SKETCH

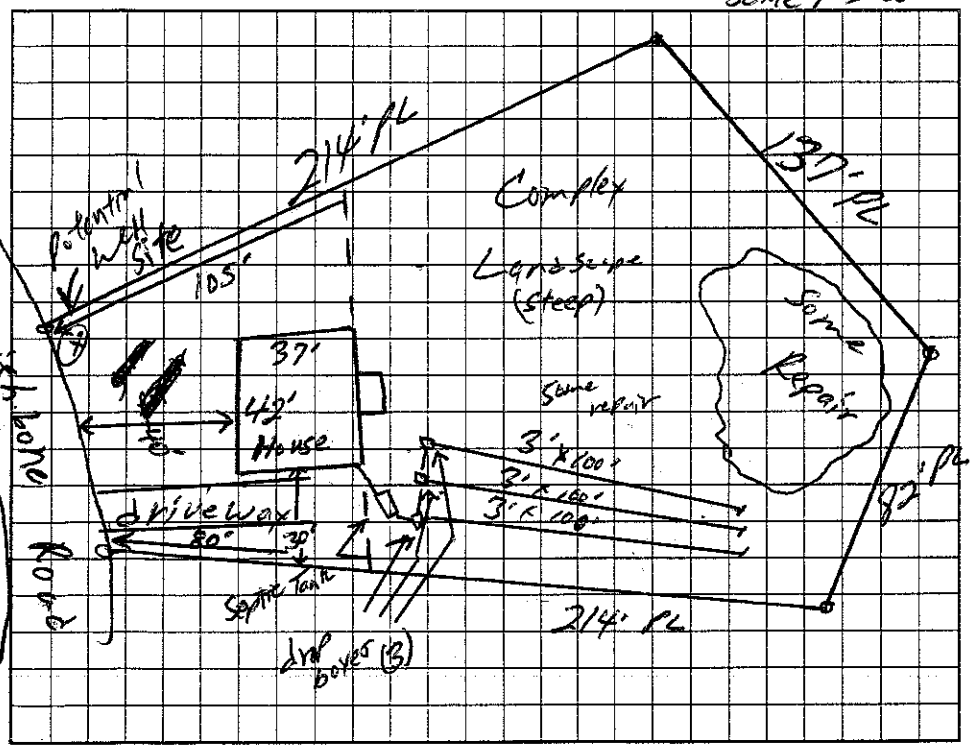

AS BUILT SKETCH

(Red Polylok Filter & ST marks Installed)

48 Infiltrator Chambers Installed

Installed As Shown per Initial Site Sketch

Permit can be suspended or revoked if any false information is supplied toward securing the permit/any unauthorized changes are made to the site/any unauthorized changes are made in the installation of the system. Improvement Permit with plat valid without expiration. Improvement Permit with site plan valid for sixty months. Authorization to Construct is valid for a period equal to that of Improvement Permit – not to exceed sixty months.

Signed: Duane Landrum date 12-30-02 Installed by: Abernathy Grading + Septic

Improvement Permit by: William O. Johnson date 7/17/02 Operation Permit by: William O. Johnson date 12/22/04

Authorization to Construct by: William O. Johnson date 7/17/02 Existing System Inspection by: ____ date ____

HEALTH DEPT. COPY: WHITE OWNER COPY (FINAL): YELLOW OWNER COPY (INITIAL): PINK