IREDELL COUNTY HEALTH DEPARTMENT

STATESVILLE 704-878-5305 175.00 Paid CI MOORESVILLE 704-664-5281

IMPROVEMENT PERMIT / AUTHORIZATION TO CONSTRUCT / OPERATION PERMIT / EXISTING SYSTEM INSPECTION

PERMIT# 095478 PIN# 4710-50-6057 DATE 10/8/01

OWNER OR CONTRACTOR Bo of NC Inc PHONE: Business 704-425-1600 Home

ADDRESS 5734 Hwy 150 E Denver NC 28037

LOCATION DMR, TR Buffalo Shoals, TL Laurel Cove TL Island Terrace on LT

SUBDIVISION River Hill Est BLOCK / SECTION LOT 15 LOT AREA 0.52 AC SITE CLASS PS DESIGN FLOW 360 L.T.A.R. 0.25

Septic Tank: 1000 Gallons; STB 312 Date 10-5-01
Pump Tank: Gallons; PT Date
Pump Make: Model Serial No
Nitrification Field: No Fields 1 Square Feet 1080 Linear Feet 360
No Lines 4 Trench Width 36" Max Trench Bottom Depth 36"

☒ New System ☐ Repair System Type: I, II, III, IV, V, VI
System Description: Gravity 25% Reduct.
Repair System Description: Pump Panel
Maintenance Agreement Required: ☐ Yes ☒ No
Gravel Depth —


☒ House/Mod. Home ☐ Mobile Home ☐ Business ☐ Other
No. Bedrooms 3 No. Bathrooms 3 No. Employees
☐ Slab ☒ Crawl Space ☐ Basement w/plumbing ☐ Basement wo/plumbing

Water Supply: ☒ Individual ☐ Public ☐ Community

Comments/Conditions:

Comments/Conditions: LABEL FILTER & MARKER INSTALLED AS SHOWN

INITIAL SITE SKETCH

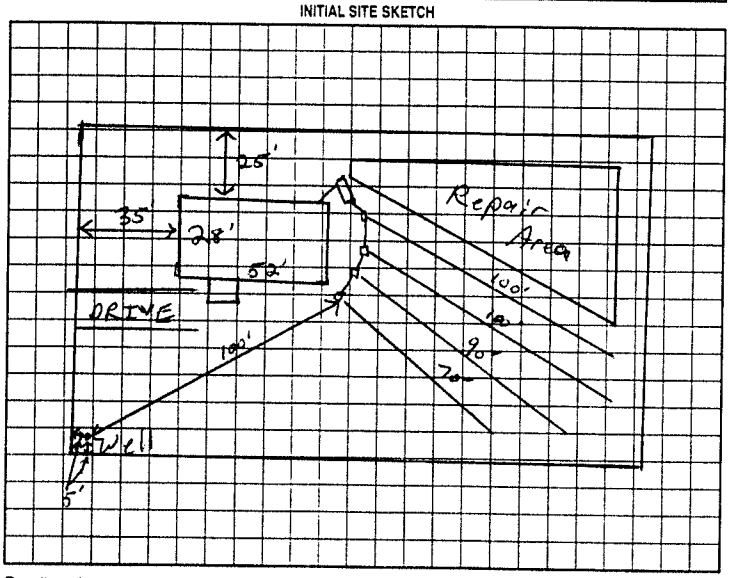

AS BUILT SKETCH

Permit can be suspended or revoked if any false information is supplied toward securing the permit/any unauthorized changes are made to the site/any unauthorized changes are made in the installation of the system. Improvement Permit with plat valid without expiration. Improvement Permit with site plan valid for sixty months. Authorization to Construct is valid for a period equal to that of Improvement Permit - not to exceed sixty months.

Signed: Maine Lovelace date 10-9-01 Installed by: TIM AMMONS

Improvement Permit by: RSI date 10/8/01 Operation Permit by: RS date 11-15-01

Authorization to Construct by: RSI date 10/8/01 Existing System Inspection by: date

HEALTH DEPT. COPY. WHITE OWNER COPY (FINAL) YELLOW OWNER COPY (INITIAL) PINK