ELL COUNTY HEALTH DEPARTMENT

Statesville Office (704) 878-5305 Mooresville Office (704) 660-3625

EMENT PERMIT / AUTHORIZATION TO CONSTRUCT / OPERATION PERMIT / EXISTING SYSTEM

PERMIT # 214109

SITE ADDRESS: Eric Ward — APPLICANT ADDRESS: 1124 Charlotte Hwy

SITE DIRECTIONS: 151 Island Terrace Rd Statesville NC — PHONE: 704-883-6148 — PIN # 4711507085

SUBDIVISION: 115 to old mtn to Buffalo Shoals to Laural Cove to Island Terrace Rd — ALT. PHONE: N/A

River Hills Estates — SECTION: N/A — LOT # 14 — LOT AREA: 0.635ac

Septic Tank	1000 (gal)	STB	1012-1000	Date	8-8-14	☑ New System	☐ Repair	☐ Expansion	System Type: I II ☒ III IV V VI
Pump Tank	(gal)	PT		Date		System Description:	25% Reduction hyn capacity		
Pump Make		Model		Serial #		Repair System Description:	50% Reduction		
# Nitrification Fields	1	# Lines	4	Linear Ft:	400	Maintenance Agreement Required:	☐ YES	☒ NO	
Trench Width	36"	Max. Trench Bottom Depth	48" high side	Gravel Depth	N/A		☒ GRAVITY	☐ PRESSURE	

DESIGN FLOW: 360 — L.T.A.R.: 0.3

☒ Residence ☐ Business ☐ Other ☐ Slab ☐ Basement w/plumbing


No. Bedrooms 3 — No. Persons 6 — No. Employees — ☒ Crawl Space

Water Supply: ☑ Private ☐ Public ☐ Community

☐ Basement w/o plumbing


Comments / Conditions: Install 25% reduction high-capacity on contour with serial distribution. Maintain 48" trench depth on high side. No foundation drain unless system can be below drain

INITIAL SITE SKETCH

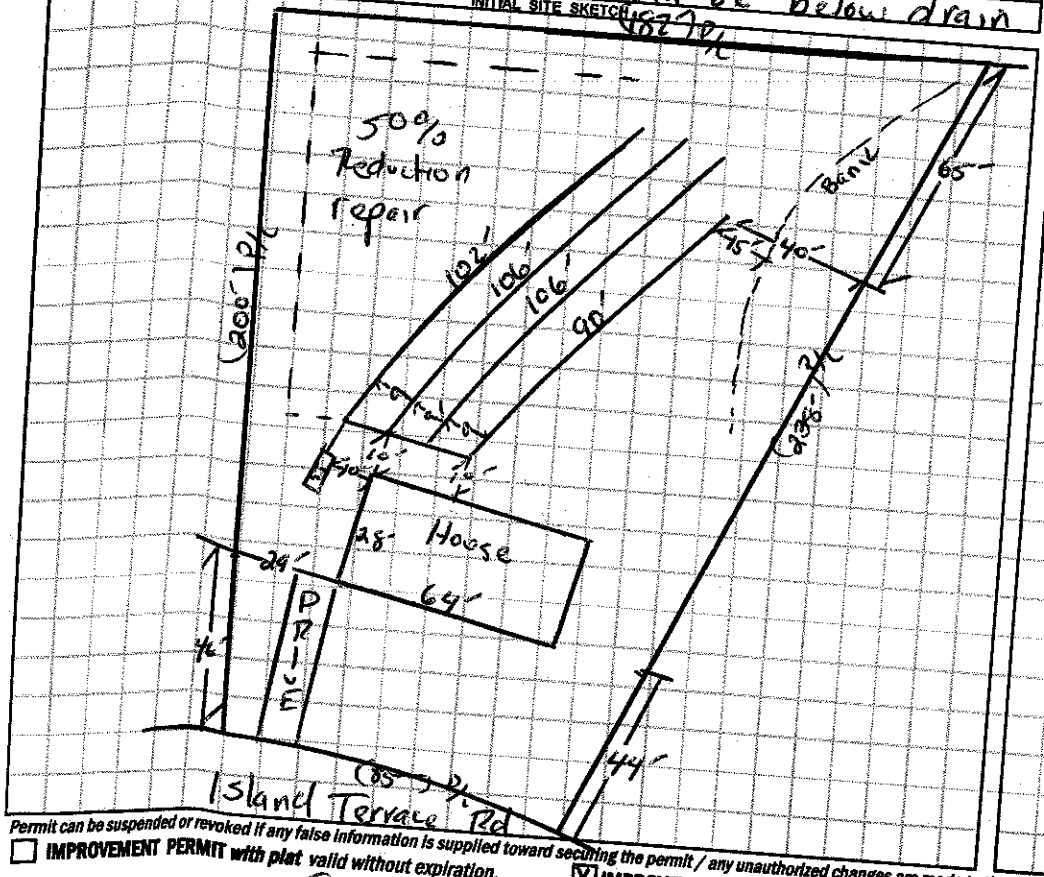

AS BUILT SKETCH

1"=50

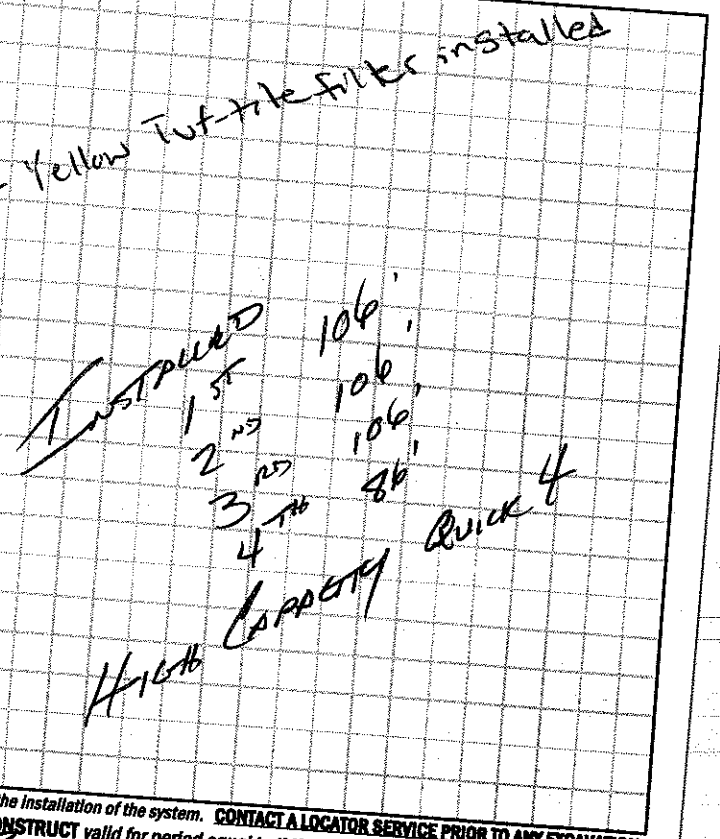

Permit can be suspended or revoked if any false information is supplied toward securing the permit / any unauthorized changes are made to the site / any unauthorized changes are made in the installation of the system.

☐ IMPROVEMENT PERMIT with plat valid without expiration.

☒ IMPROVEMENT PERMIT with site plan valid for 60 mos.

☒ AUTHORIZATION TO CONSTRUCT valid for period equal to IMPROVEMENT PERMIT--not to exceed 60 mo.

CONTACT A LOCATOR SERVICE PRIOR TO ANY EXCAVATION

Owner / Applicant Signature: Eric Ward

IMPROVEMENT PERMIT by: Date: 12/8/15

AUTHORIZATION TO CONSTRUCT by: Date: 12/7/15

Installed by: Frye Construction

OPERATION PERMIT by: Date: 12/8/15

Existing System Inspected by: Date: 3/2/16

Health Dept. Copy - WHITE Applicant (Final Approval) - YELLOW Applicant (Construction) - PINK