IREDELL COUNTY HEALTH DEPARTMENT

STATESVILLE 704-878-5305 MOORESVILLE 704-664-5281

IMPROVEMENT PERMIT / AUTHORIZATION TO CONSTRUCT / OPERATION PERMIT / EXISTING SYSTEM INSPECTION

PERMIT# 87770 PIN# 4711555928 DATE April 4, 2000

OWNER OR CONTRACTOR Valerie Browns PHONE: Business _____ Home 873 2564

ADDRESS Po Bx 125 Barium Springs

LOCATION Buffalo Shoals West (L) Pinewlle (R) Lockhart To end on Right

SUBDIVISION _____ BLOCK / SECTION _____ LOT _____ LOT AREA 1.61 Ac SITE CLASS. PS DESIGN FLOW 360 L.T.A.R. .3

Septic Tank: 1000 Gallons; STB 825 Date 01/08/03

Pump Tank: _____ Gallons; PT _____ Date _____

Pump Make: _____ Model 300 Serial No. 300

Nitrification Field: No Fields 1 Square Feet 1200 Linear Feet ~~400~~

No Lines 5 Trench Width 36 Max Trench Bottom Depth 36-40" Gravel Depth 12-14"

(X) New System ( ) Repair System Type: I, II, III, IV, V, VI 25%

System Description: ~~Conventional~~ GRAVITY REDUCTION

Repair System Description: Pump 25% Reduction OR Conventional

Maintenance Agreement Required: ( ) Yes (X) No

(X) House/Mod. Home ( ) Mobile Home ( ) Business ( ) Other


No. Bedrooms 3 No. Bathrooms 2 No. Employees ____

( ) Slab (X) Crawl Space ( ) Basement w/plumbing ( ) Basement wo/plumbing

Water Supply: (X) Individual ( ) Public ( ) Community WELL


Comments:/Conditions: Locate well 100ft or max. Feasible distance (50ft min) from system. Bring drive along property line. Keep TANK As high As possible. Set plumbing outlet To insure proper TANK position

INITIAL SITE SKETCH

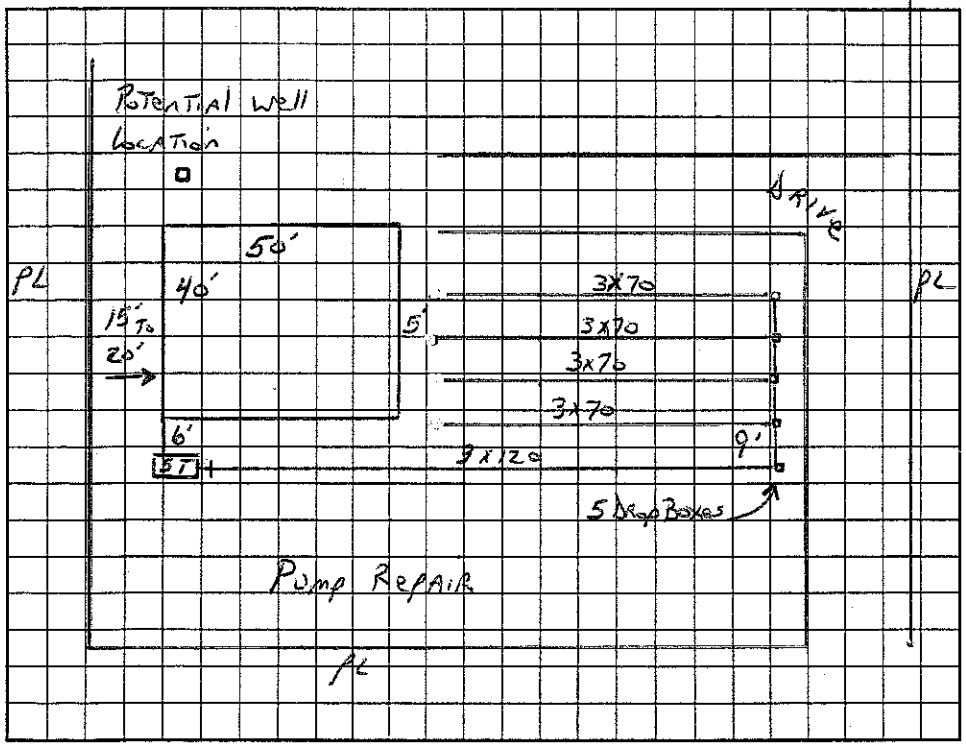

Comments:/Conditions: SEPTIC TANK INSTALLED USING POLY-LOC-FILTER, SYSTEM ALTERED AS SHOWN DUE TO IMPROPER INITIAL INSTALLATION (TOO MUCH FALL ON LINES)

AS BUILT SKETCH

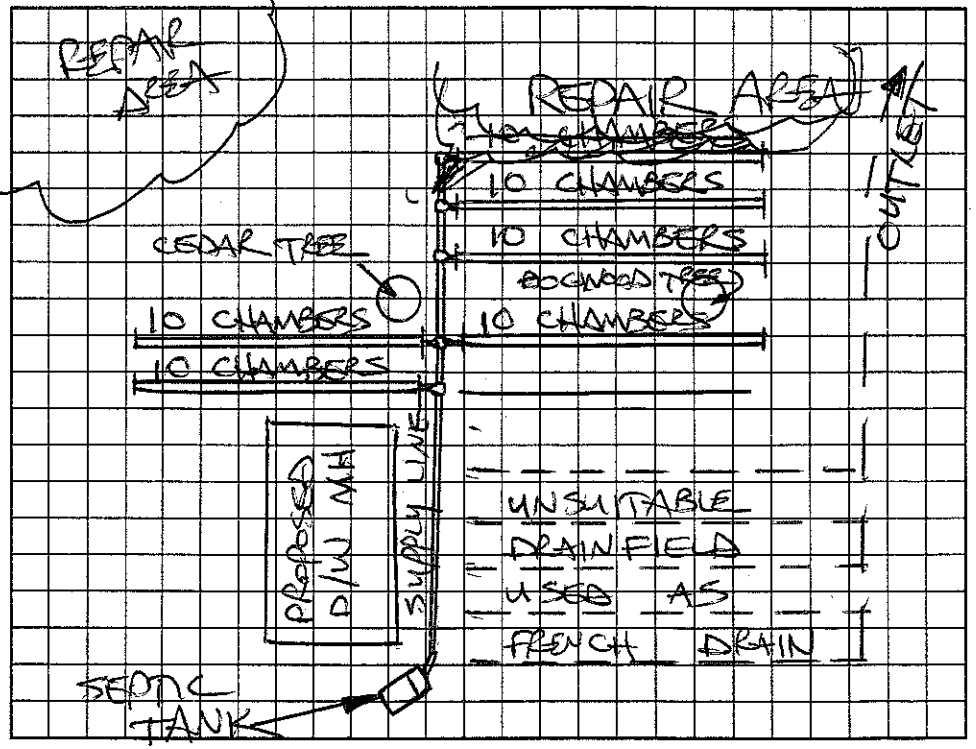

Permit can be suspended or revoked if any false information is supplied toward securing the permit/any unauthorized changes are made to the site/any unauthorized changes are made in the installation of the system. Improvement Permit with plat valid without expiration. Improvement Permit with site plan valid for sixty months. Authorization to Construct is valid for a period equal to that of Improvement Permit – not to exceed sixty months.

Signed: Emmett Brown date 4-27-00 Installed by: H. E. Houston

Improvement Permit by: Lyc Potter date April 4 2000 Operation Permit by: STEVE HEDRICK date 4-2-03

Authorization to Construct by: Lyc Potter date April 4 2000 Existing System Inspection by: _____ date _____

HEALTH DEPT. COPY: WHITE OWNER COPY (FINAL): YELLOW OWNER COPY (INITIAL): PINK