IREDELL COUNTY HEALTH DEPARTMENT

STATESVILLE 704-878-5305 MOORESVILLE 704-664-5281

IMPROVEMENT PERMIT / AUTHORIZATION TO CONSTRUCT / OPERATION PERMIT / EXISTING SYSTEM INSPECTION

PERMIT# 79348 PIN# 4711561860 DATE 12-31-98

OWNER OR CONTRACTOR Rodney James PHONE: Business _____ Home 528 0404

ADDRESS 2311 Buffalo Shoals Rd

LOCATION Buffalo Shoals Rd To Long branch 2nd lot left

SUBDIVISION _____ BLOCK / SECTION _____ LOT _____ LOT AREA 1.63 acres SITE CLASS PS DESIGN FLOW 240 L.T.A.R. .33

Septic Tank: 1000 Gallons: STB 1012 Date 10-13-98
Pump Tank: _____ Gallons: PT _____ Date _____
Pump Make: _____ Model _____ Serial No. _____
Nitrification Field: No Fields 1 Square Feet 1720 Linear Feet 240
No Lines 3 Trench Width 36" Max Trench Bottom Depth 36" Gravel Depth 12"

☐ New System ☐ Repair System Type: I II III IV V VI
System Description: Conv. Gravity
Repair System Description: Gravity 25% Red
Maintenance Agreement Required: ☐ Yes ☐ No


☐ House/Mod. Home No. Bedrooms 2
☐ Mobile Home No. Bathrooms 2
☐ Business No. Employees ____
☐ Other _____

☐ Slab ☐ Crawl Space ☐ Basement w/plumbing ☐ Basement wo/plumbing

Water Supply: ☐ Individual ☐ Public ☒ Community

Comments/Conditions:

INITIAL SITE SKETCH

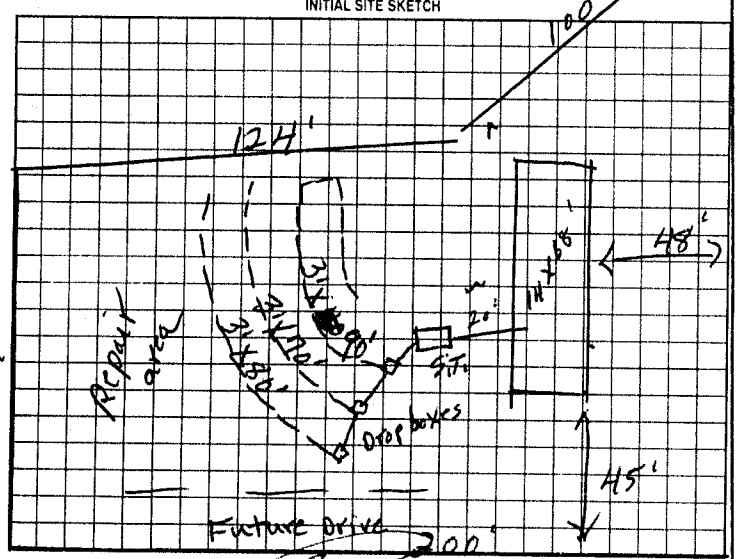

Comments/Conditions

AS BUILT SKETCH

Same as initial Sketch

Permit can be suspended or revoked if any false information is supplied toward securing the permit/any unauthorized changes are made to the site/any unauthorized changes are made in the installation of the system. Improvement Permit with plat valid without expiration. Improvement Permit with site plan valid for sixty months. Authorization to Construct is valid for a period equal to that of Improvement Permit – not to exceed sixty months.

Signed: _____ date _____ Installed by: Forest Shuford

Improvement Permit by: R. C. Moore date 12-31-98 Operation Permit by: R. C. Moore date 1-13-99

Authorization to Construct by: R. C. Moore date 12-31-98 Existing System Inspection by: _____ date _____

HEALTH DEPT COPY: WHITE OWNER COPY (FINAL): YELLOW OWNER COPY (INITIAL): PINK