IREDELL COUNTY HEALTH DEPARTMENT

Statesville Phone TR 3-7271 Mooresville Phone NO 3-1271

PERMIT TO INSTALL SEPTIC TANK

Permit No. 144 Permit Date 9-15 1972

Owner Paul Johnson Address Statesville

Installed By Henry Dorman Address Statesville N.C.


Location of Property Out Buffalo Shoals Road past East Mombo Road - Trailer on left. (Not located at time of inspection)

Tank		Capacity		Length of Lines		Fixtures	
Block	( )	1000	(✓)	225'	(✓)	No. of Baths	( )
Precast	(✓)	1250	( )	250'	( )	Dishwasher	( )
		1500	( )	Other		Garbage Grdr.	( )
		Other				Other	

NOTIFY HEALTH DEPARTMENT AT LEAST EIGHT HOURS BEFORE TANK IS TO BE INSPECTED.

Final Inspection 9-15 1972 Approved (✓) Disapproved ( )

Remarks Community water

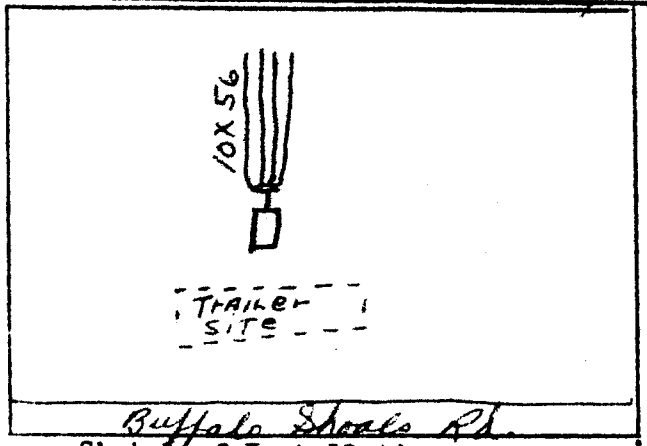

Sketch of Installation

E. G. Stevenson

Sanitarian