Site Address: 144 Harold Ln - Lot 1

IREDELL COUNTY HEALTH DEPARTMENT

STATESVILLE 704-878-5305 MOORESVILLE 704-664-5281

IMPROVEMENT PERMIT / AUTHORIZATION TO CONSTRUCT / OPERATION PERMIT / EXISTING SYSTEM INSPECTION

PERMIT# 139564 PIN# 4711562392 DATE 22 December 06

OWNER OR APPLICANT Cindy West / Garland Wilcox PHONE: Business Home 704-528-2850

ADDRESS P.O. Box 176 Barium Springs, N.C. 28010

LOCATION Buffalo Shoals - 6.0 past Pinewille Rd - Th Harold Ln. 1st Lot on Rt.

SUBDIVISION Buffalo Heights BLOCK / SECTION LOT 9 LOT AREA 0.521 ac. SITE CLASS. PS DESIGN FLOW 360 gpd L.T.A.R. 0.3 gpd/sf/ft2

Septic Tank: 1000 Gallons: STB TP-1012-1008 Date 4-11-06

Pump Tank: Gallons; PT Date

Pump Make: Model Serial No.

Nitrification Field: No Fields 1 Square Feet 1200 Linear Feet 300

No Lines 4 Trench Width 36" Max Trench Bottom Depth 36" Gravel Depth NA

☑ New System ☐ Repair ☐ Expansion System Type: I II III IV V VI

System Description: 25% Reduction Accepted

Repair System Description: 25% Reduction - Pressure

Maintenance Agreement Required: ☐ Yes ☐ No

☑ House/Mod. Home ☑ Mobile Home ☐ Business ☐ Other

No. Bedrooms 3 No. Persons No. Employees


Water Supply: ☑ Individual ☐ Public ☐ Community

☑ Gravity ☐ Pressure ☐ Slab ☑ Crawl Space ☐ Basement w/plumbing ☐ Basement w/o plumbing


Comments/Conditions: Follow contour / use 3 drop-boxes /

Comments/Conditions: ST Nos marker / Filter installed /

INITIAL SITE SKETCH

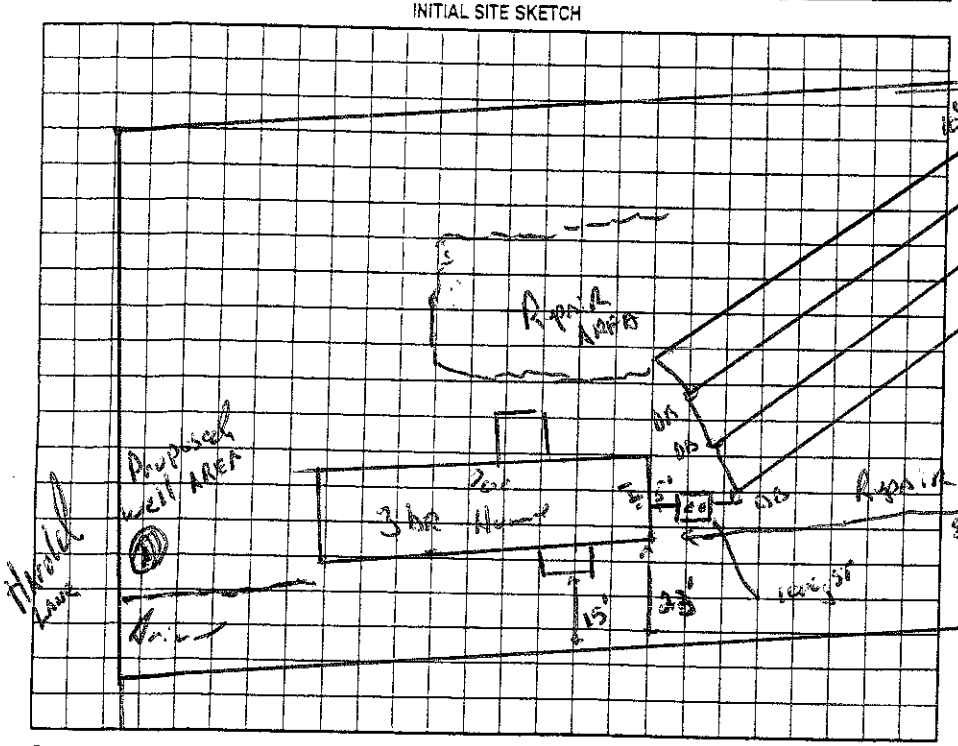

AS BUILT SKETCH

 

Permit can be suspended or revoked if any false information is supplied toward securing the permit/any unauthorized changes are made to the site/any unauthorized changes are made in the installation of the system. Improvement Permit with plat valid without expiration ☐ Improvement Permit with site plan valid for sixty months ☑ Authorization to Construct is valid for a period equal to that of Improvement Permit – not to exceed sixty months.

Signed: date 12-27-06 Installed by: Dale Wingler

Improvement Permit by: R.S. date 27 December 06 Operation Permit by: R.S. date 17 JAN 07

Authorization to Construct by: R.S. date 27 December 06 Existing System Inspection by: date

HEALTH DEPT. COPY: WHITE OWNER COPY (FINAL): YELLOW OWNER COPY (INITIAL): PINK