IREDELL COUNTY HEALTH DEPARTMENT

STATESVILLE 704-878-5305 (C1) MOORESVILLE 704-664-5281

IMPROVEMENT PERMIT / AUTHORIZATION TO CONSTRUCT / OPERATION PERMIT / EXISTING SYSTEM INSPECTION

PERMIT# 113294 PIN# 4711-56-5361 DATE 6-25-03

OWNER OR CONTRACTOR TONY POOLE PHONE: Business _____ Home 704-873-0343

ADDRESS 3967 HICKORY HWY, STATESVILLE NC 28677

LOCATION BUFFALO SHOALS ROAD TL HAROLD LANE, LAST LOT ON LEFT

SUBDIVISION BUFFALO HEIGHTS BLOCK / SECTION B LOT 8 LOT AREA 0.55 ACRE SITE CLASS. PS DESIGN FLOW 360 L.T.A.R. 0.30 GPD/FT²

Septic Tank: 1000 Gallons; STB 1092 Date 3-7-03
Pump Tank: _____ Gallons; PT _____ Date _____
Pump Make: _____ Model _____ Serial No. _____
Nitrification Field: No Fields 1 Square Feet EQ. No 1200 Linear Feet 200
No Lines FOUR Trench Width 24" Max Trench Bottom Depth 36" ~~Gravel~~ Depth SAND 24"

☑ New System ☐ Repair System Type: I, II, (III), IV, V, VI
System Description: 50% REDUCTION, GRAVITY
Repair System Description: 50% REDUCTION, LOW PRESSURE
Maintenance Agreement Required: ☐ Yes ☐ No


☐ House/Mod. Home ☑ Mobile Home ☐ Business ☐ Other
No. Bedrooms 3 No. Bathrooms 2 No. Employees ____

☐ Slab ☐ Crawl Space ☐ Basement w/plumbing ☐ Basement wo/plumbing

Water Supply: ☑ Individual ☐ Public ☐ Community WELL


Comments/Conditions: ① INSTALL SUBSURFACE INTERCEPT DRAINAGE DITCH AT LOCATION SHOWN BEGINNING 48" DEEP - PAST SYSTEM, THEN OUT TO DAYLIGHT ② INSTALL 50% REDUCTION SYSTEM AS SHOWN USING 48 PDBPS PANELS

INITIAL SITE SKETCH

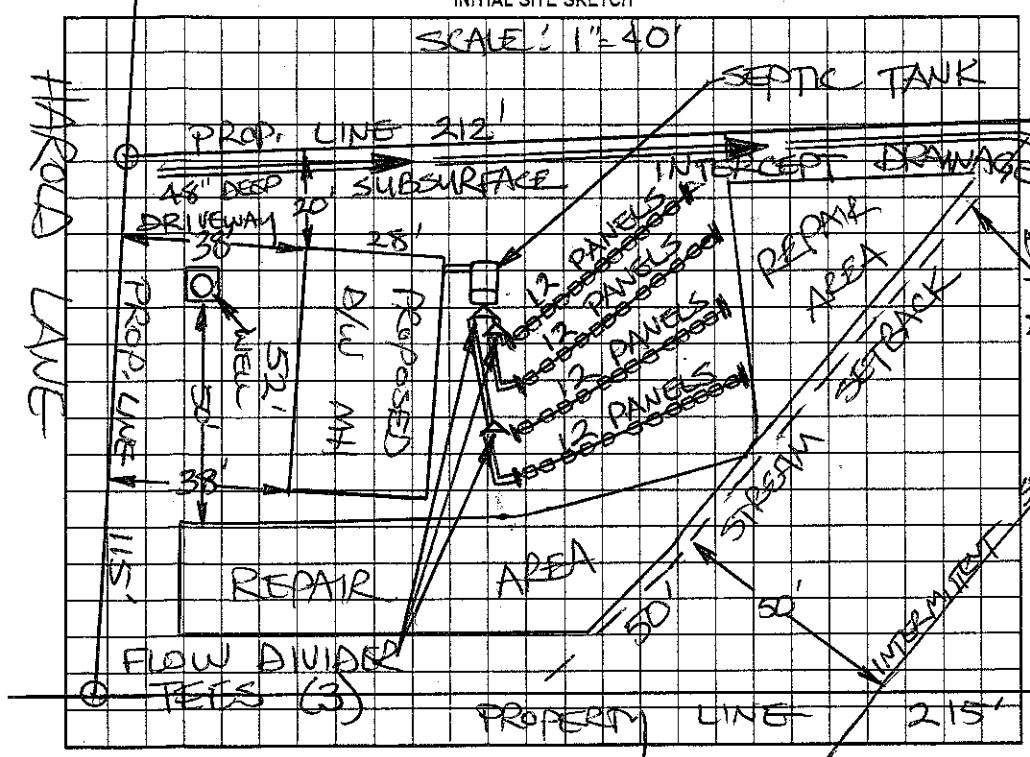

AS BUILT SKETCH

Comments/Conditions: NO CUTTING OR FILLING OF SOIL IN AREA OF DRAINFIELD ALLOWED
SEPTIC TANK WITH MARKER INSTALLED
USING "TUFTITE" FILTER

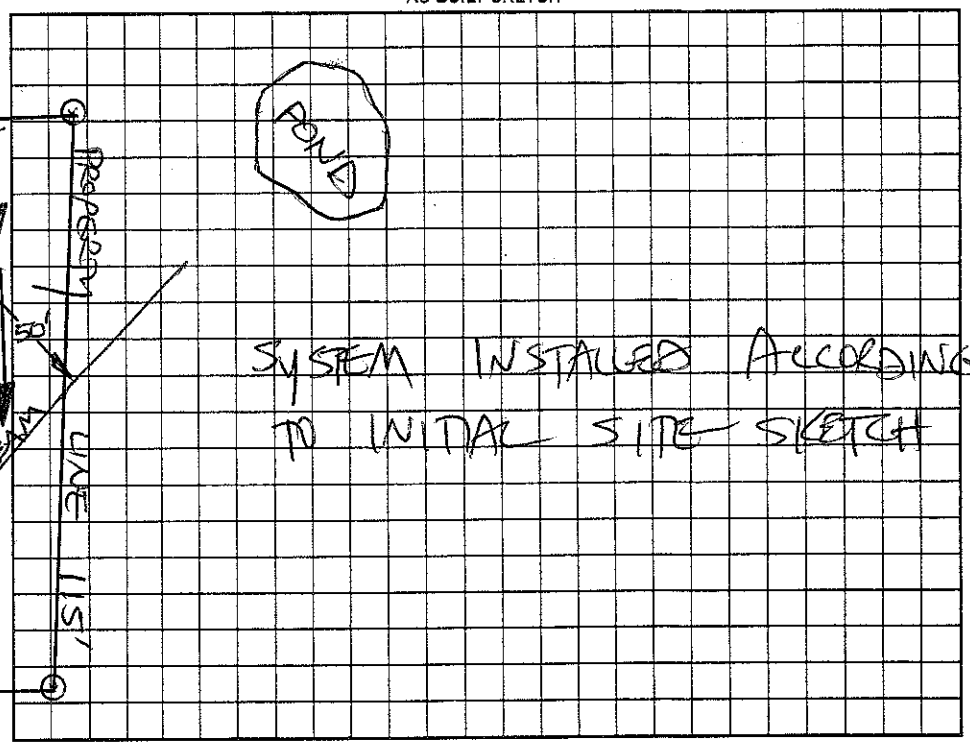

Permit can be suspended or revoked if any false information is supplied toward securing the permit/any unauthorized changes are made to the site/any unauthorized changes are made in the installation of the system. Improvement Permit with plat valid without expiration. Improvement Permit with site plan valid for sixty months. Authorization to Construct is valid for a period equal to that of Improvement Permit – not to exceed sixty months.

Signed: Tonny Poole date 7/1/2003 Installed by: CRAIG THOMPSON

Improvement Permit by: STEVE HEDRICK date 6-25-03 Operation Permit by: STEVE HEDRICK date 9-29-03

Authorization to Construct by: STEVE HEDRICK date 6-25-03 Existing System Inspection by: _____ date _____

HEALTH DEPT. COPY: WHITE OWNER COPY (FINAL): YELLOW OWNER COPY (INITIAL): PINK