THIS PERMIT VOIDS PREVIOUS PERMIT ISSUED 12-9-99

IREDELL COUNTY HEALTH DEPARTMENT

STATESVILLE 704-878-5305 MOORESVILLE 704-664-5281

IMPROVEMENT PERMIT / AUTHORIZATION TO CONSTRUCT / OPERATION PERMIT / EXISTING SYSTEM INSPECTION

PERMIT# 08123 PIN# 4711565471 DATE 11-8-02

OWNER OR CONTRACTOR PATSY TRANTHAM PHONE: Business 4/0 704-662-9091 Home 704-392-9625

ADDRESS 7115 BELTHAVEN BLVD, #80, CHARLOTTE NC 28216

LOCATION BUFFALO SHOALS ROAD, TL HAROLD LANE LOT #7 AT END ON LEFT

SUBDIVISION BUFFALO HEIGHTS BLOCK / SECTION ____ LOT 7 LOT AREA 0.55 ACRE SITE CLASS PS DESIGN FLOW 240 L.T.A.R. 0.30 GPD/FT²

Septic Tank: 1000 Gallons: STB 160 Date 07/09/99
Pump Tank: ____ Gallons: PT ____ Date ____
Pump Make: ____ Model ____ Serial No ____
Nitrification Field: No Fields 1 Square Feet 150 Linear Feet 50
No Lines ONE Trench Width 36" Max Trench Bottom Depth 36" Gravel Depth 12"

☑ New System ☐ Repair System Type: I II III IV V VI
System Description: CONVENTIONAL, GRAVITY
Repair System Description: 50% REDUCTION, GRAVITY
Maintenance Agreement Required: ☐ Yes ☑ No
☐ Slab ☑ Crawl Space ☐ Basement w/plumbing ☐ Basement wo/plumbing


☐ House/Mod. Home ☑ Mobile Home ☐ Business ☐ Other
No. Bedrooms 2 No. Bathrooms 2 No. Employees ____

Water Supply: ☑ Individual ☐ Public ☐ Community
WELL

Comments/Conditions: ① RELOCATE EXISTING SEPTIC TANK TO LOCATION SHOWN ② RELOCATE OR INSTALL NEW DROP BOXES AS SHOWN ③ CREATE 3' WIDE EARTHEN DAM AT LOCATIONS SHOWN ④ EXPAND EXISTING LINE BY 3'x50'


Comments/Conditions:

INITIAL SITE SKETCH

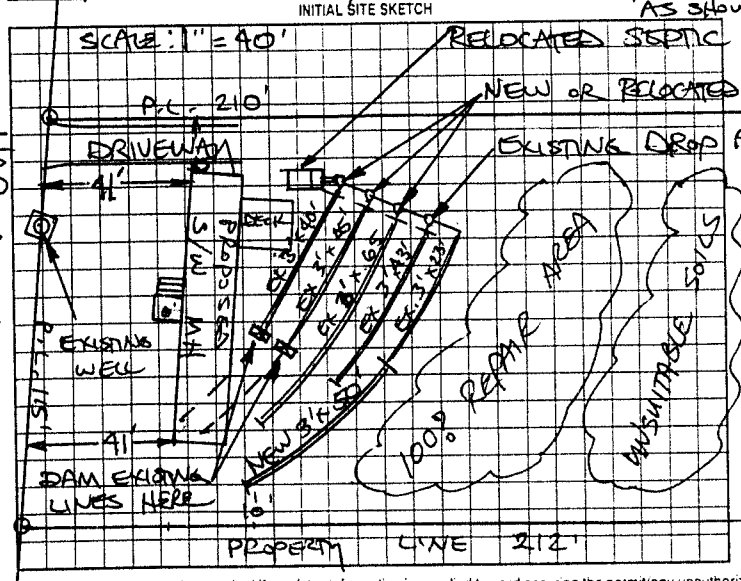

AS SHOWN

AS BUILT SKETCH

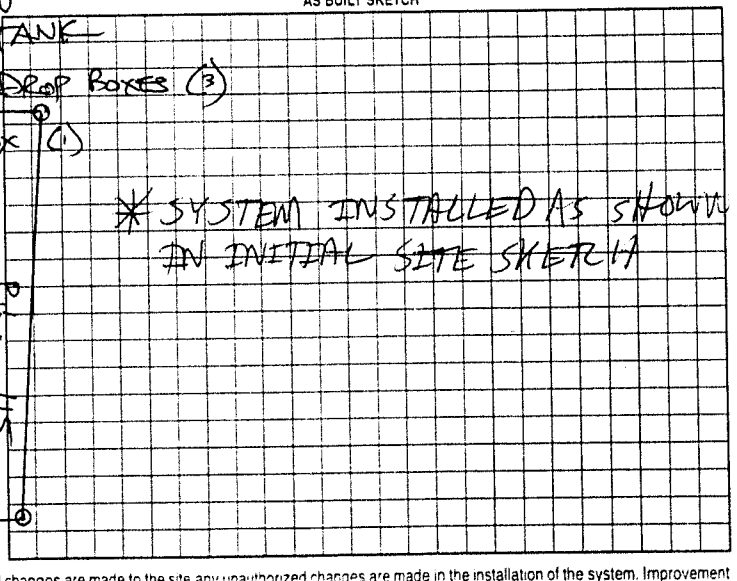

Permit can be suspended or revoked if any false information is supplied toward securing the permit/any unauthorized changes are made to the site any unauthorized changes are made in the installation of the system. Improvement Permit with plat valid without expiration. Improvement Permit with site plan valid for sixty months. Authorization to Construct is valid for a period equal to that of Improvement Permit - not to exceed sixty months.

Signed: Pat Trantham date 11-8-02 Installed by: STEVE JORDAN

Improvement Permit by: STEVE HEDRICK date 11-8-02 Operation Permit by: [signature] date 11/27/02

Authorization to Construct by: STEVE HEDRICK date 11-8-02 Existing System Inspection by: ____ date ____

HEALTH DEPT COPY WHITE OWNER COPY (FINAL) YELLOW OWNER COPY (INITIAL) PINK