IREDELL COUNTY HEALTH DEPARTMENT

STATESVILLE 704-878-5305 (I) MOORESVILLE 704-664-5281

IMPROVEMENT PERMIT / AUTHORIZATION TO CONSTRUCT / OPERATION PERMIT / EXISTING SYSTEM INSPECTION

PERMIT# 12521 PIN# 4711-57-3623 BJET SMITH DATE 12-8-04

OWNER OR CONTRACTOR EXPRESSION HOMES PHONE: Business 704-746-5312 Home 704-528-7460

ADDRESS 1042 CHARLOTTE HWY TROUTMAN NC 28166

LOCATION BUFF SHOALS WEST 1ST LOT ON LEFT PAST HAROLD LANE

SUBDIVISION ~~BUFFALO SHOALS PHASE~~ BLOCK/SECTION ____ LOT 15 LOT AREA 1.044AC SITE CLASS. PS DESIGN FLOW 360 L.T.A.R. .3

Septic Tank: 1000 Gallons; STB 1012 Date 7-25-04
Pump Tank: 1000 Gallons; PT 17 Date 10-7-04
Pump Make: ~~ZOELLER~~ MYERS Model ME50S-11 Serial No. 25327 D
Nitrification Field: No Fields 1 Square Feet EW=1400 Linear Feet 200'
No Lines 4X50' Trench Width 24" Max Trench Bottom Depth 36" Gravel Depth N/A

☒ New System ☐ Repair System Type: I, II, (III) IV, V, VI
System Description: PUMP ~~ZOELLER~~ 50% REDUCT
Repair System Description: LOW PRESS 50% REDUCT
Maintenance Agreement Required: ☐ Yes ☒ No


☒ House/Mod. Home No. Bedrooms 3
☐ Mobile Home No. Bathrooms 2
☐ Business No. Employees ____
☐ Other ____
☐ Slab ☒ Crawl Space ☐ Basement w/plumbing ☐ Basement wo/plumbing

Water Supply: ☐ Individual ☐ Public ☒ Community


Comments/Conditions: (1) INSTALL LINES ON CONTOURS (2) MAINTAIN SETBACKS (3) SYSTEM FLAGGED OUT COMPLETELY (4) MAINTAIN SETBACKS

Comments/Conditions: SYSTEM INSTALLED AS FLAGGED & SETBALLS MAINTAINED OFF OF SURVEYORS EASEMENT LINES
~~TURNDOWN~~ ELECTRICAL TWILE ON 2-9-05

1"=50' INITIAL SITE SKETCH

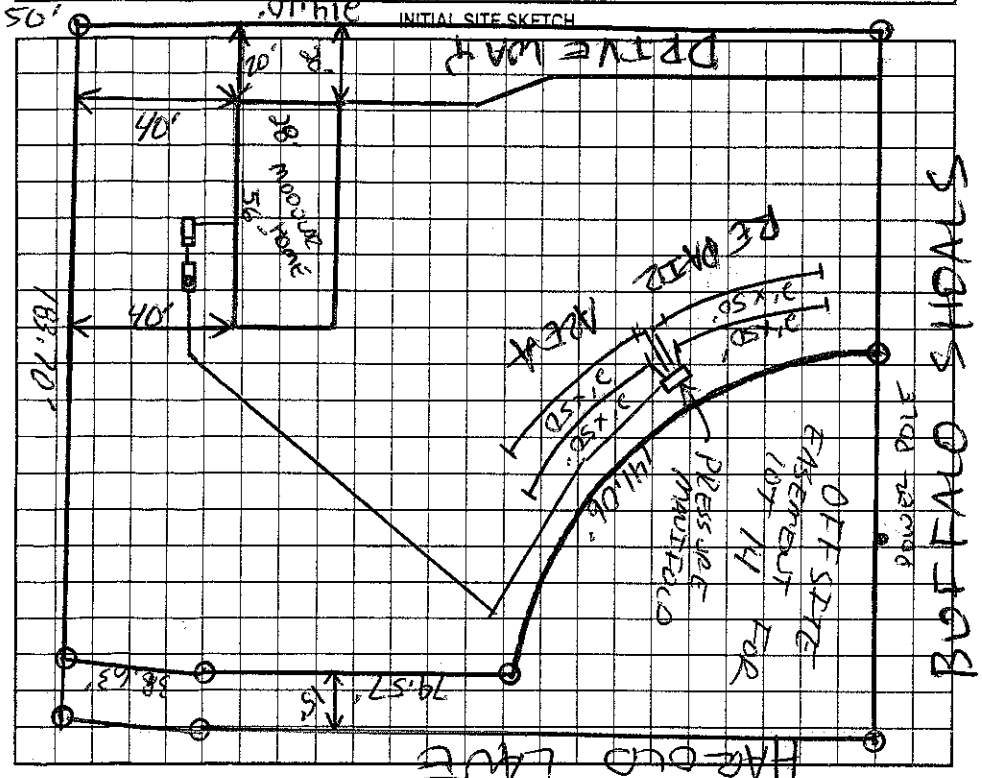

AS BUILT SKETCH

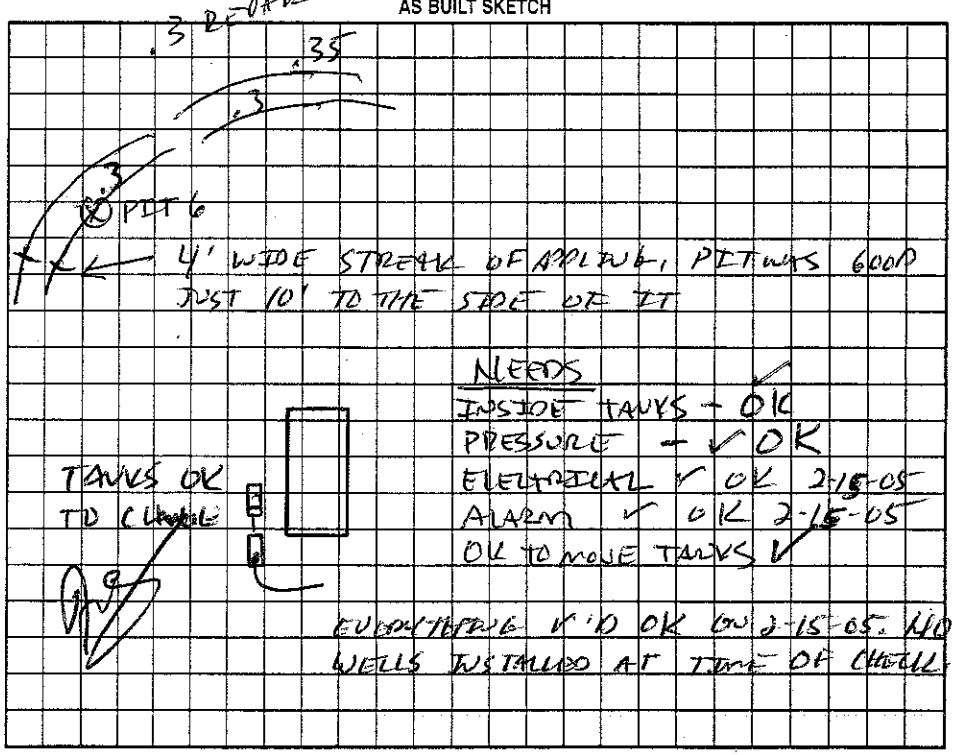

Permit can be suspended or revoked if any false information is supplied toward securing the permit/any unauthorized changes are made to the site/any unauthorized changes are made in the installation of the system. Improvement Permit with plat valid without expiration. Improvement Permit with site plan valid for sixty months. Authorization to Construct is valid for a period equal to that of Improvement Permit – not to exceed sixty months.

Signed: _____ date 12/9/04 Installed by: C. THOMPSON

Improvement Permit by: _____ date 12-8-04 Operation Permit by: _____ date 2-15-05

Authorization to Construct by: _____ date 12-8-04 Existing System Inspection by: _____ date _____

HEALTH DEPT. COPY: WHITE OWNER COPY (FINAL): YELLOW OWNER COPY (INITIAL): PINK