IREDELL COUNTY HEALTH DEPARTMENT

Statesville Phone TR 3-7271 Mooresville Phone No. 664-5281

PERMIT TO INSTALL SEPTIC TANK

Permit No. _____ Permit Date 6-25 1973

Owner C. V. STEWART Address STATESVILLE NC

Installed By SAM OSTWALT Address TROUTMAN N.C.


Location of Property Buffalo Shoals Rd. Just Past E. Mombo Rd. Corner Lot at New Street Trailer.

Tank		Capacity		Length of Lines		Fixtures	
Block	( )	1000	(✓)	225'	(✓)	No. of Baths	( )
Precast	(✓)	1250	( )	250'	( )	Dishwasher	( )
		1500	( )	Other _____		Garbage Grdr.	( )
		Other _____				Other _____	

NOTIFY HEALTH DEPARTMENT AT LEAST EIGHT HOURS BEFORE TANK IS TO BE INSPECTED.

Final Inspection 6-25 1973 Approved (✓) Disapproved ( )

Remarks No Well at time of inspection

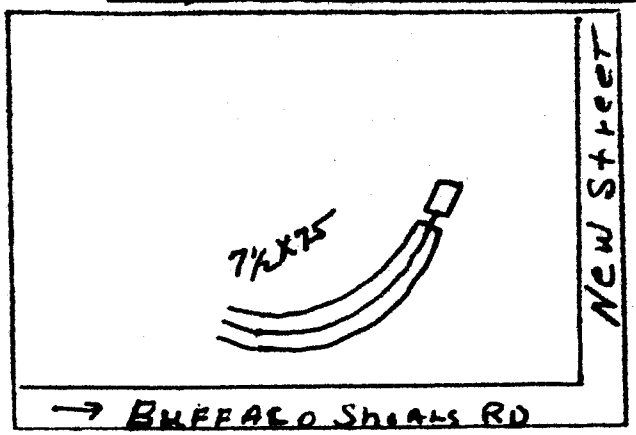

Sketch of Installation

Trailer Not on lot when inspected

E. A. Stevenson

Sanitarian