IREDELL COUNTY HEALTH DEPARTMENT

STATESVILLE 704-878-5305 MOORESVILLE 704-664-5281

IMPROVEMENT PERMIT / CERTIFICATE OF COMPLETION / OPERATION PERMIT / EXISTING SYSTEM INSPECTION

PROPERTY DESCRIPTION NO. 70686 DATE 12-11-97 TAX MAP NO. 4911581876 Watershed: ☑ Yes ☐ No

OWNER OR CONTRACTOR Shannon L. Tadlock PHONE: Business Home 528 0690 (WSIV PA)

ADDRESS 154 Troutman Shoals Rd

LOCATION Buffalo Shoals before River TR Troutman Shoals 1/4mi on Rt back off Rd

SUBDIVISION Troutman Shoals BLOCK / SECTION LOT 2 LOT AREA 2.13 acres SITE CLASS. PS DESIGN FLOW 240 L.T.A.R. .25

Septic Tank: 1000 Gallons; STB 788 Date 6-23-98

Pump Tank: Gallons; PT Date

Pump Make: Model Serial No.

Nitrification Field: No Fields 1 Square Feet 900 Linear Feet 300

No Lines 3 Trench Width 36" Max Trench Bottom Depth 24" Gravel Depth 12"

☐ New System ☐ Repair System Type: I, II, III, IV, V, VI

System Description: Conv. Gravity

Repair System Description: Pump To chambers

Maintenance Agreement Required: ☐ Yes ☐ No

☐ House/Mod. Home ☑ Mobile Home ☐ Business ☐ Other

No. Bedrooms 2 No. Bathrooms 1 No. Employees


☐ Slab ☑ Crawl Space ☐ Basement w/plumbing ☐ Basement wo/plumbing

Water Supply: ☑ Individual ☐ Community ☐ Public


Comments: 24" maximum Trench depth

Comments:

INITIAL SITE SKETCH

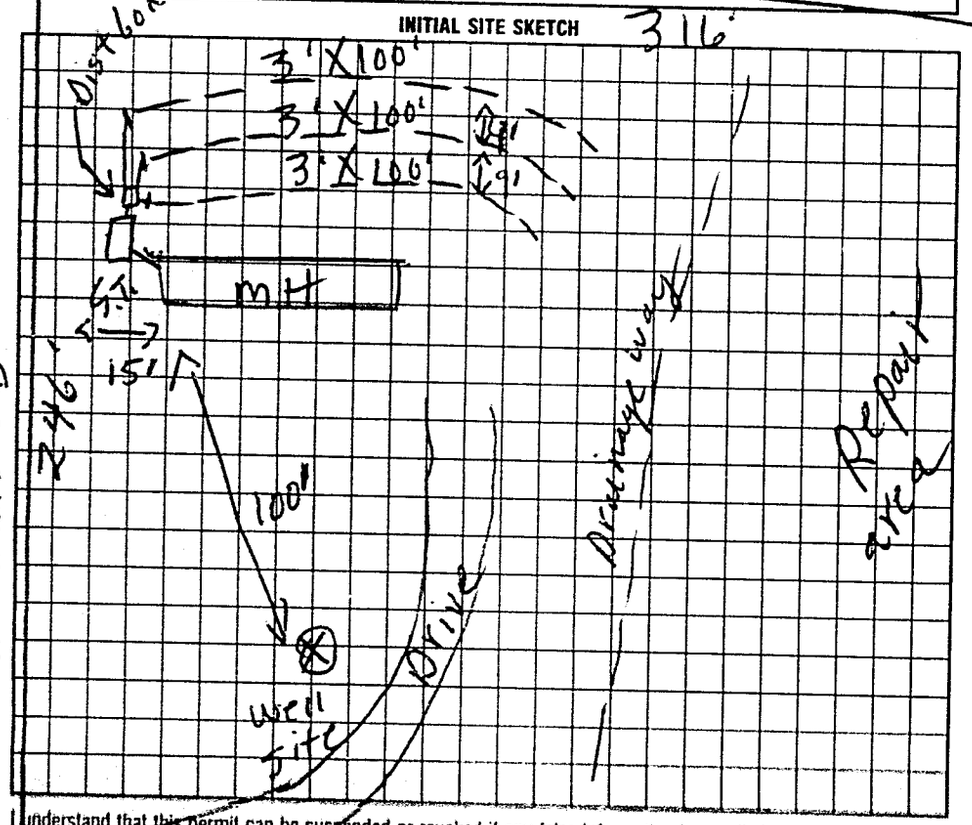

AS BUILT SKETCH

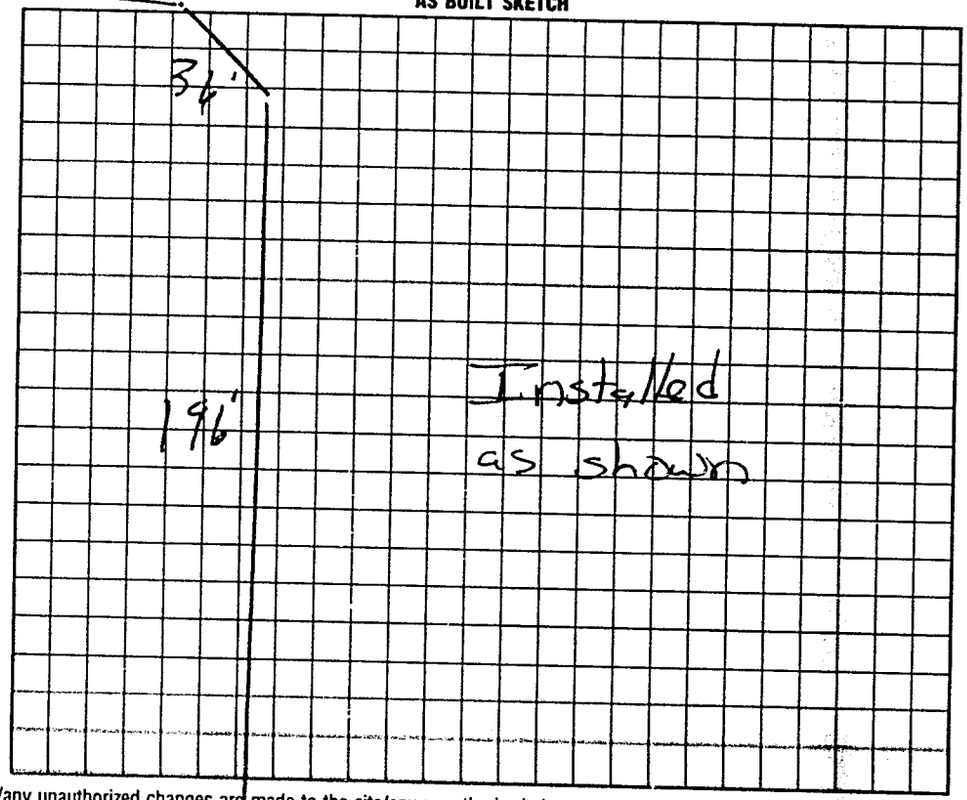

I understand that this permit can be suspended or revoked if any false information is supplied toward securing the permit/any unauthorized changes are made to the site/any unauthorized changes are made in the installation of the system. Improvement Permit is valid for 60 months from date of issuance.

Signed: x Shannon L Tadlock

Improvement Permit by: E.C. Moore date 12-11-97

Existing System Inspection by: E.C. Moore date 12-11-97

Authorization to Count.

Installed by: Catawba Septic

Certificate of Completion by: date

Operation Permit by Mark C. Ortz RS date 8-12-98

Authorization to Count EXPires 60 mos from issue

APPLICANT COPY WHITE INSPECTION COPY (FINAL) GREEN OWNER COPY (FINAL) YELLOW INSPECTION COPY (INITIAL) PINK OWNER COPY (INITIAL) GOLD