IREDELL COUNTY HEALTH DEPARTMENT

STATESVILLE 704-878-5305 (C1) MOORESVILLE 704-664-5281

IMPROVEMENT PERMIT / AUTHORIZATION TO CONSTRUCT / OPERATION PERMIT / EXISTING SYSTEM INSPECTION

PERMIT# 106790 PIN# 4711-58-7049 "Doano" DATE 6/14/02

OWNER OR CONTRACTOR Todd + Pam Williams PHONE Business (704) 924-2997 Home —

ADDRESS Williams-Abernathy Rd Maiden NC 28650

LOCATION Old Mtn Rd, (R) on Buffalo Shoals towards Catawba River about 2½ mile ON Right beside T. West pond.

SUBDIVISION — BLOCK / SECTION — LOT — LOT AREA ± 2.0 Ac SITE CLASS PS DESIGN FLOW 360 L.T.A.R. .35 gpd/ft²

Septic Tank: 4000 Gallons: STB 620 Date 12-2-02 — X New System ☐ Repair System Type: I (II) III IV V VI — X House/Mod. Home No. Bedrooms 3 — Water Supply: X Individual ☐ Public ☐ Community

Pump Tank: — Gallons: PT — Date — — System Description: Gravity, Conventional — ☐ Mobile Home No. Bathrooms 2

Pump Make: — Model — Serial No — Repair System Description: Gravity, 25% Reduction — ☐ Business No. Employees —


Nitrification Field: No Fields 1 Square Feet 1029 Linear Feet 343 — Maintenance Agreement Required: ☐ Yes X No — ☐ Other —

No Lines 4 Trench Width 36" Max Trench Bottom Depth 36" Gravel Depth 12" — ☐ Slab X Crawl Space ☐ Basement w/plumbing ☐ Basement wo/plumbing

Comments/Conditions: ① Install liner on contour ② maintain 6" cover Set backs


(Not to Scale)

INITIAL SITE SKETCH

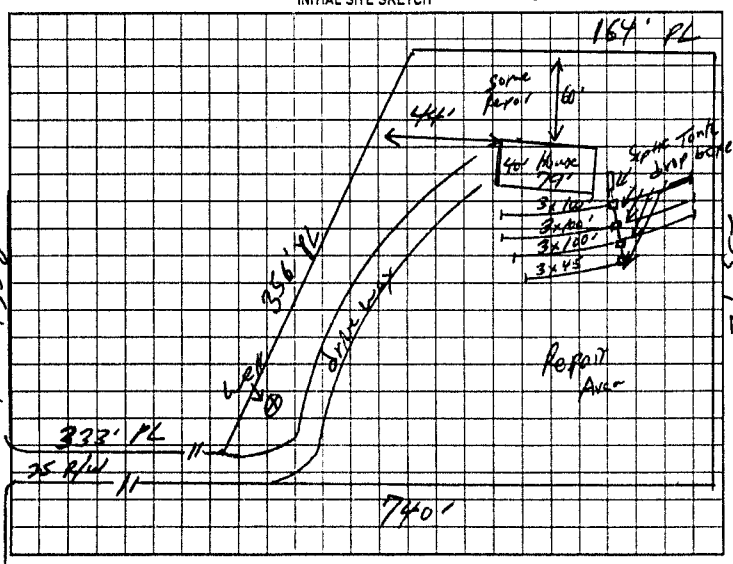

Comments/Conditions: ① SEPTIC TANK WITH MARKER INSTALLED USING "ZABEL" FILTER ② SYSTEM ALTERED AS SHOWN DUE TO EXISTING WATER LINE

AS BUILT SKETCH

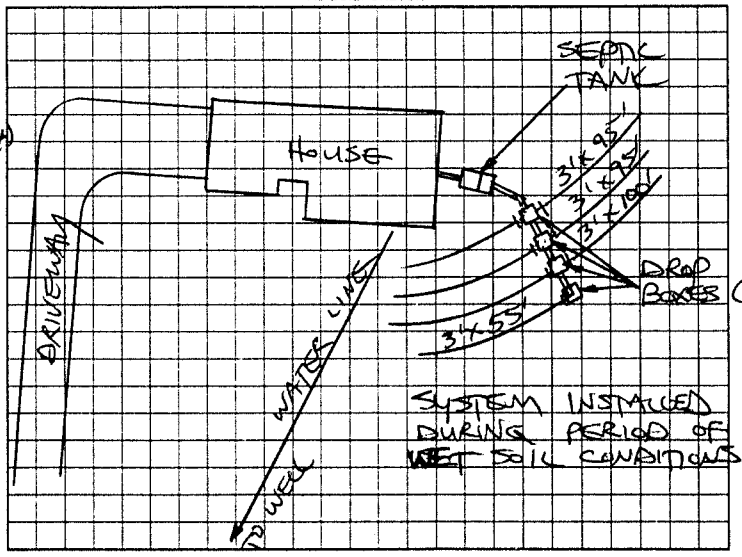

Permit can be suspended or revoked if any false information is supplied toward securing the permit/any unauthorized changes are made to the site/any unauthorized changes are made in the installation of the system. Improvement Permit with plat valid without expiration. Improvement Permit with site plan valid for sixty months. Authorization to Construct is valid for a period equal to that of Improvement Permit – not to exceed sixty months

Signed: Pam Williams date 6/14/02 installed by SAMMY REAVIS

Improvement Permit by: William E. Johnson date 6/14/02 Operation Permit by: STEVE HEDRICK date 12-30-02

Authorization to Construct by: William E. Johnson date 6/14/02 Existing System Inspection by: — date —

HEALTH DEPT. COPY: WHITE OWNER COPY (FINAL): YELLOW OWNER COPY (INITIAL): PINK