1:30

IREDELL COUNTY HEALTH DEPARTMENT

Statesville Office (704) 878-5305 Mooresville Office (704) 660-3625 PERMIT # 224031

IMPROVEMENT PERMIT / AUTHORIZATION TO CONSTRUCT / OPERATION PERMIT / EXISTING SYSTEM

PIN # 4711650424

APPLICANT: Joseph Keenan APPLICANT ADDRESS: 305 Wagner St Troutman NC

SITE ADDRESS: 194 Braxton Dr Statesville NC PHONE: 704-528-1987 ALT. PHONE: 704-634-2069


SITE DIRECTIONS: Buffalo Shoals Rd T/L Pineville Rd T/R on Braxton Dr lot on right

SUBDIVISION: Pineville Rd Estates SECTION: N/A LOT # 20 LOT AREA: 1.71 ac DESIGN FLOW: 360 L.T.A.R.: 0.25

Septic Tank	1000 (gal)	STB 1012.	Date 3-4-17.	☒ New System	☐ Repair	☐ Expansion	System Type: I II ☒ III IV V VI	☒ Residence	No. Bedrooms 3	Water Supply					
Pump Tank	(gal)	PT	Date	System Description: 25% Reduction				☐ Business	No. Persons 6	☒ Private					
Pump Make	Model		Serial #	Repair System Description: 50% Reduction				☐ Other	No. Employees	☐ Public					
# Nitrification Fields 1	# Lines 5		Linear Ft: 360	Maintenance Agreement Required:	☐ YES	☒ NO		☐ Slab	☒ Crawl Space	☐ Community					
Trench Width 36"	Max. Trench Bottom Depth 30"		Gravel Depth N/A		☒ GRAVITY	☐ PRESSURE		☐ Basement w/plumbing		☐ Basement w/o plumbing					

Comments / Conditions: Install 25% reduction on contour with serial distribution

INITIAL SITE SKETCH

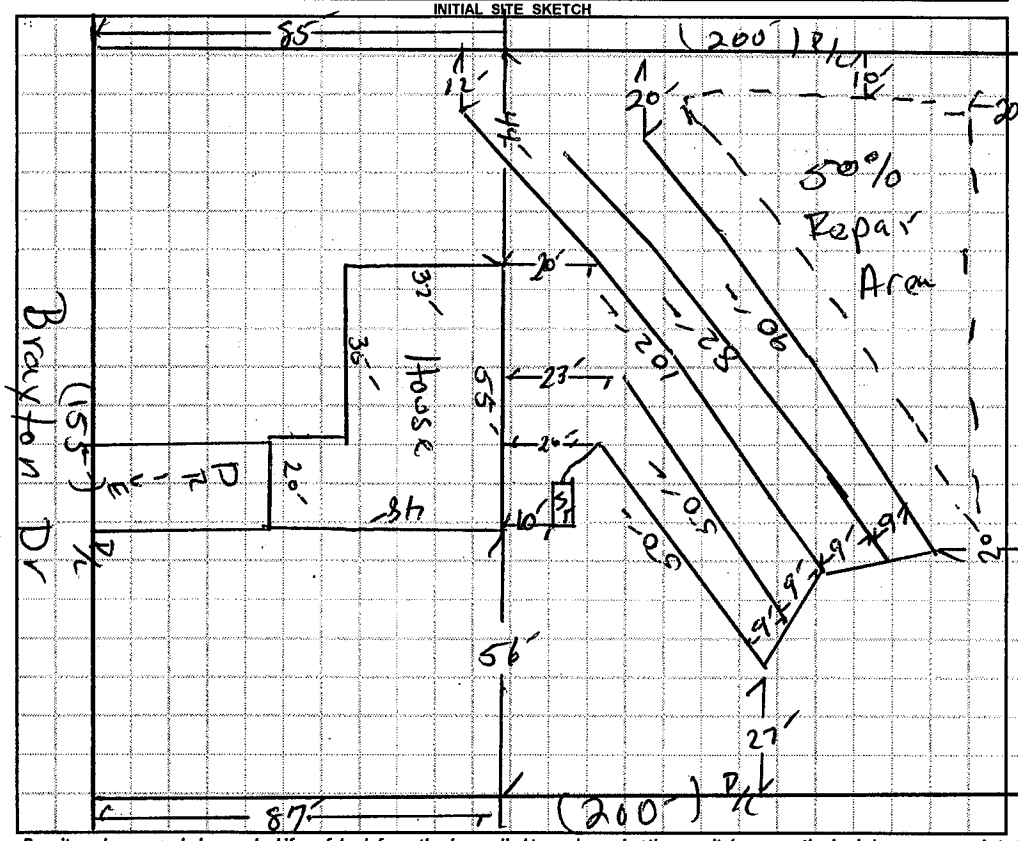

AS BUILT SKETCH

1" = 40'

Installed as drawn.

Permit can be suspended or revoked if any false information is supplied toward securing the permit / any unauthorized changes are made to the site / any unauthorized changes are made in the installation of the system. **CONTACT A LOCATOR SERVICE PRIOR TO ANY EXCAVATION**

☐ **IMPROVEMENT PERMIT** *with plat valid without expiration.* ☒ **IMPROVEMENT PERMIT** *with site plan valid for 60 mos.* ☒ **AUTHORIZATION TO CONSTRUCT** *valid for period equal to IMPROVEMENT PERMIT--not to exceed 60 mo.*

Owner / Applicant Signature: Date: 2/3/17 Installed by: Steve Jordan

IMPROVEMENT PERMIT by: Date: 02/02/17 OPERATION PERMIT by: Benjamin A. Bolling Date: 6/7/2017.

AUTHORIZATION TO CONSTRUCT by: Date: 02/02/17 Existing System Inspected by: Date:

Health Dept. Copy - WHITE Applicant (Final Approval) - YELLOW Applicant (Conditional Approval) - PINK