IREDELL COUNTY HEALTH DEPARTMENT

2:00 BC

STATESVILLE 704-878-5305 MOORESVILLE 704-664-5281

IMPROVEMENT PERMIT / AUTHORIZATION TO CONSTRUCT / OPERATION PERMIT / EXISTING SYSTEM INSPECTION

PERMIT# 139375 PIN# ~~4714650240.1014~~ 4711650569 DATE 3-27-08

OWNER OR APPLICANT D&D Enterprises PHONE: Business 704-528-6192 Home

ADDRESS P.O. Box 5602 Statesville NC 28687

LOCATION BUFFALO SHOALS @ Pineville & Braxton Lot on Right

SUBDIVISION Pinwille Rd East BLOCK / SECTION ## LOT 19 LOT AREA 1.709AC SITE CLASS. PS DESIGN FLOW 360 L.T.A.R. 0.3

Septic Tank: 1060 Gallons: STB Date

Pump Tank: Gallons: PT Date

Pump Make: Model Serial No. 300'

Nitrification Field: No. Fields 1 Square Feet EQ=1200 Linear Feet [redacted]'

No Lines 4 Trench Width 36" Max Trench Bottom Depth 36" Gravel Depth N/A ☒ Gravity ☐ Pressure

☒ New System ☐ Repair ☐ Expansion System Type: I (II) III IV V VI

System Description: 60LF ET4 25% REDUCTION

Repair System Description: LP 50% REDUCT

Maintenance Agreement Required: ☐ Yes ☒ No

☒ House/Mod. Home No. Bedrooms 3

☐ Mobile Home No. Persons 6

☐ Business No. Employees


☐ Other

Water Supply: ☒ Individual ☐ Public ☐ Community

☐ Slab ☒ Crawl Space ☐ Basement w/plumbing ☐ Basement wo/plumbing


Comments/Conditions: ① System is 10' OFF P/L WITH Driveway Between Drive & Property Line ② SYSTEM MUST BE 15' OFF TOP OF 2' EMBANKMENT CUT ③ House / Drainlines / P/L's FLAGGED

INITIAL SITE SKETCH

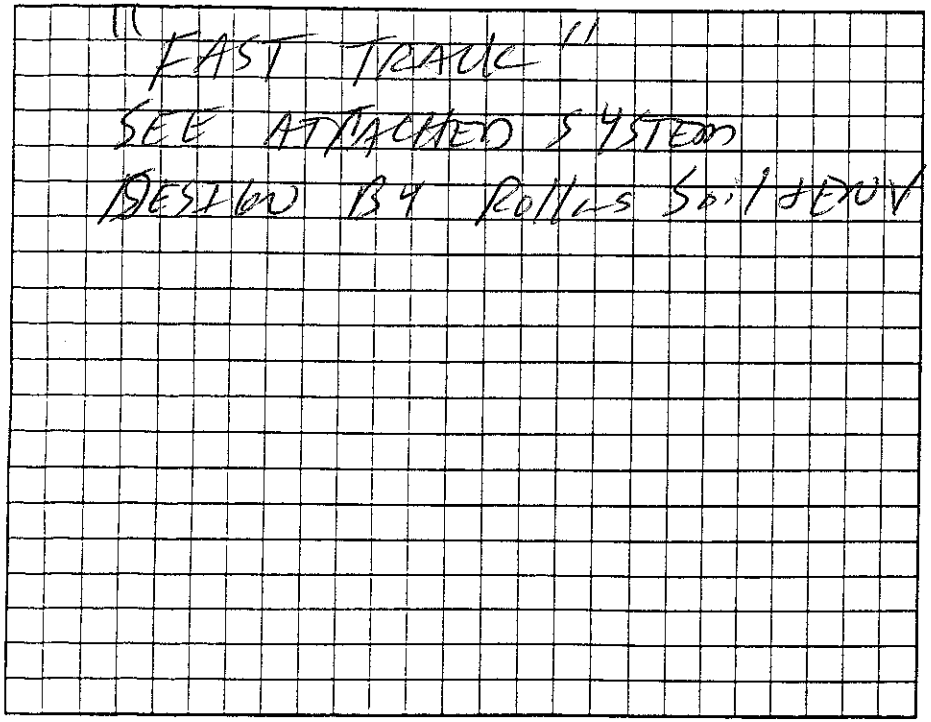

Comments/Conditions: OUT completely. ④ This is an Intermediate Redraw SD no new soil work was done, OLD soil work by [redacted] Rollins Soil SERV AND Tim Higgins Was Used to perform this REDRAW. ⑤ Front of home slopes West 5' off Proposed System. Porches, sidewalks & Decks will have to be in Home Box for front of home so system will fit. ⑥ STUBOUT IS Through Garage TO ALLOW A Gravity Fall System.

AS BUILT SKETCH

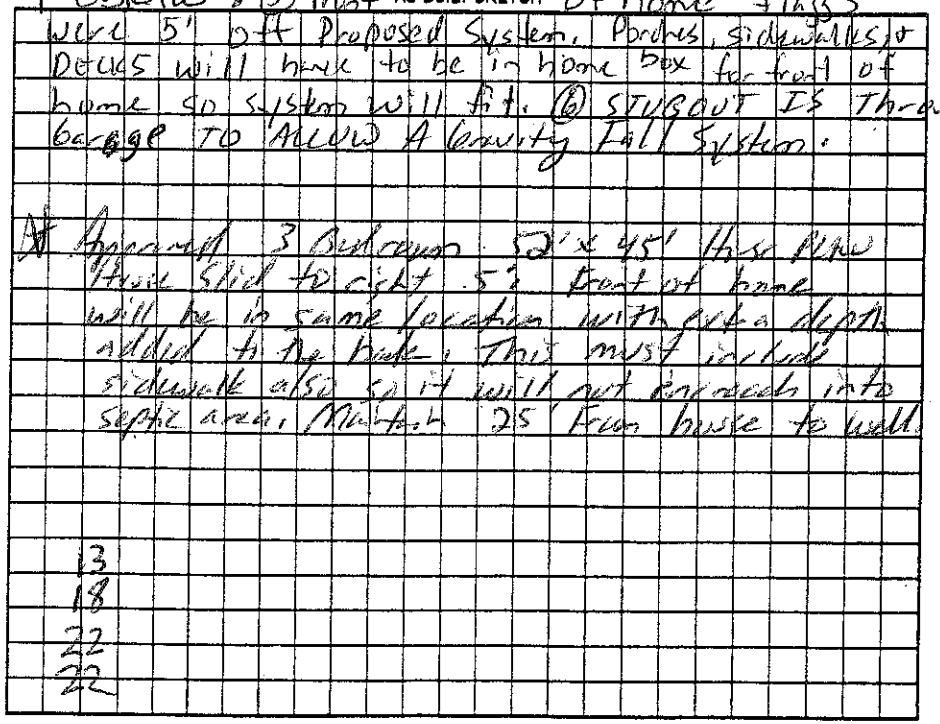

Permit can be suspended or revoked if any false information is supplied toward securing the permit/any unauthorized changes are made to the site/any unauthorized changes are made in the installation of the system. Improvement Permit with plat valid without expiration ☐ Improvement Permit with site plan valid for sixty months ☒ Authorization to Construct is valid for a period equal to that of Improvement Permit – not to exceed sixty months.

Signed: date 3/31/08

Improvement Permit by: date 3/27/08


Authorization to Construct by: date 4/24/08

Installed by: Kowan Septic

Operation Permit by: date 9-8-08

Existing System Inspection by: date

HEALTH DEPT. COPY: WHITE OWNER COPY (FINAL): YELLOW OWNER COPY (INITIAL): PINK

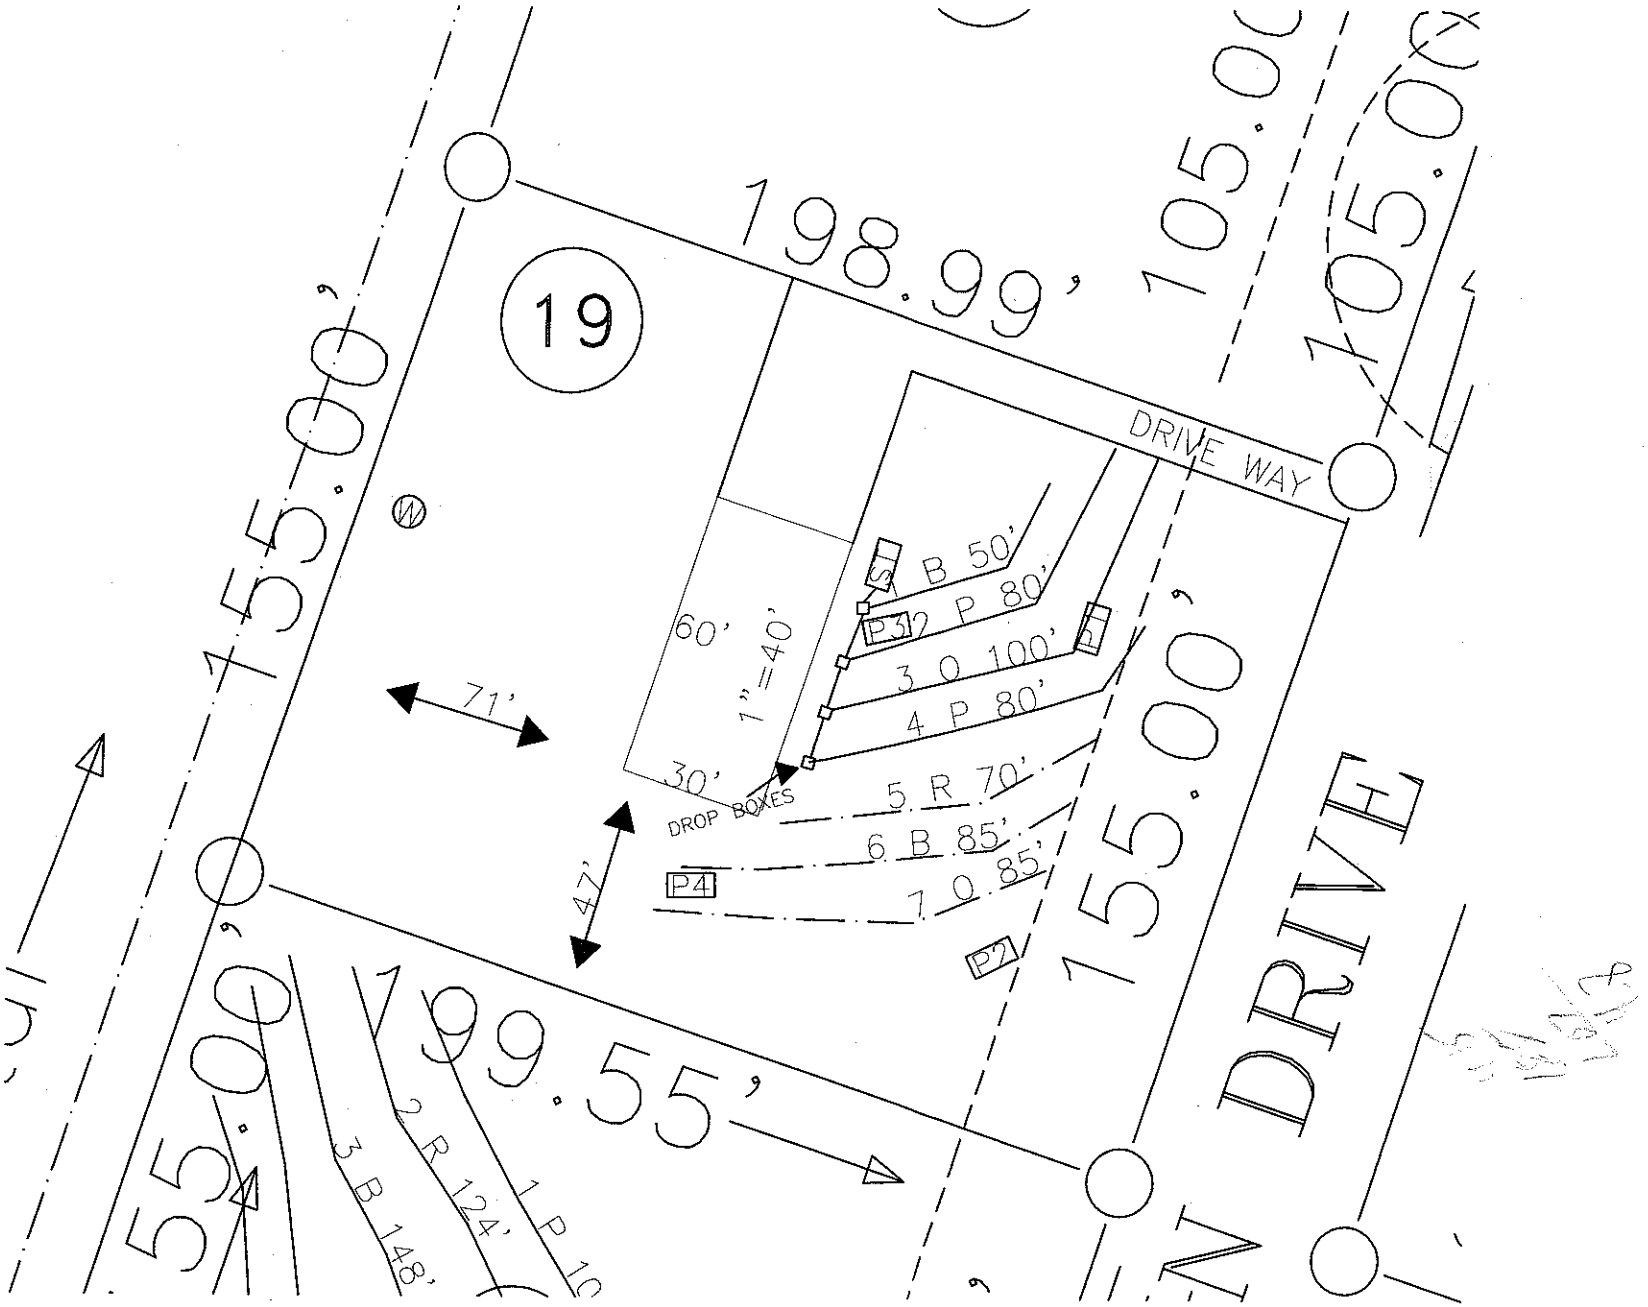
19
198.99'
105.00'
105.00'
155.00'
155.00'
DRIVE WAY
5 B 50'
P3 2 P 80'
3 O 100'
4 P 80'
5 R 70'
6 B 85'
7 O 85'
P4
P2
60'
1"=40'
71'
30'
47'
DROP BOXES
199.55'
55.00'
3 B 148'
2 R 124'
1 P 10
N DRIVE