IREDELL COUNTY HEALTH DEPARTMENT

STATESVILLE 704-878-5305 MOORESVILLE 704-664-5281

059832

IMPROVEMENT PERMIT / CERTIFICATE OF COMPLETION / OPERATION PERMIT / EXISTING SYSTEM INSPECTION

PROPERTY DESCRIPTION NO 20097 DATE 3-19-96 TAX MAP NO Pt of 3L-B-6+6J Watershed: Yes ✓ No

OWNER OR CONTRACTOR David LockHart PHONE Business Home 528-0788

ADDRESS 168 LockHart Fm Rd Sta

LOCATION Buffalo Shoals West TL Pineville Rd TR LockHart at end

SUBDIVISION N/A BLOCK / SECTION LOT SIZE/LOT AREA SITE CLASS P.S. DESIGN FLOW 240 L.T.A.R. .25

Septic Tank: 1000 Gallons: STB 1012 Date 1-14-96 ✓ New System Repair System Type I II III IV V VI

Pump Tank Gallons: PT Date

Pump Make: Model: Serial No

Nitrification Field: No Fields 1 Square Feet 720 Linear Feet 240

No Lines 3 Trench Width 36" Max Trench Bottom Depth 28" Gravel Depth N/A

System Description: Gravity Chambers

Repair System Description: Gravity Panels

Maintenance Agreement Required Yes No

✓ House/Mod. Home No Bedrooms 2

✓ Mobile Home No Bathrooms 1

Business No Employees

Other

Slab ✓ Crawl Space Basement w/plumbing Basement wo/plumbing


Water Supply: ✓ Individual Community Public

Well Next door


Comments: This permit Replaces Permit Issued 3-8-95.

Comments

INITIAL SITE SKETCH

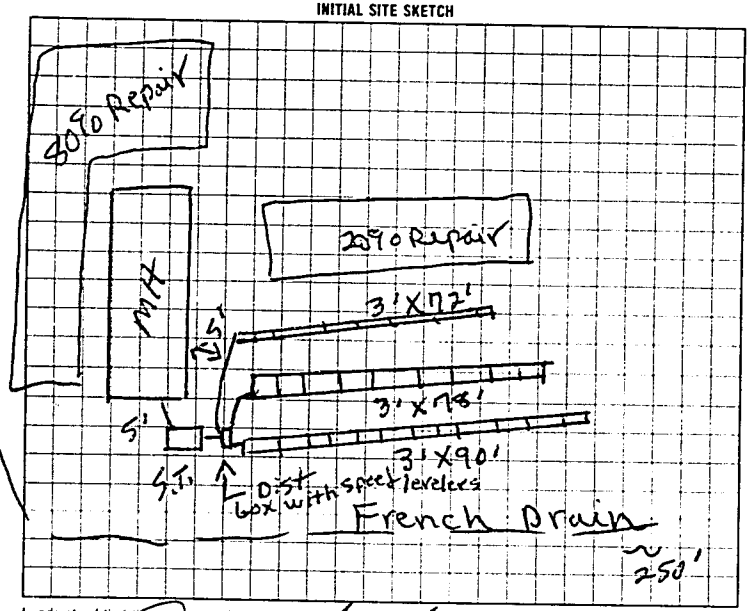

AS BUILT SKETCH

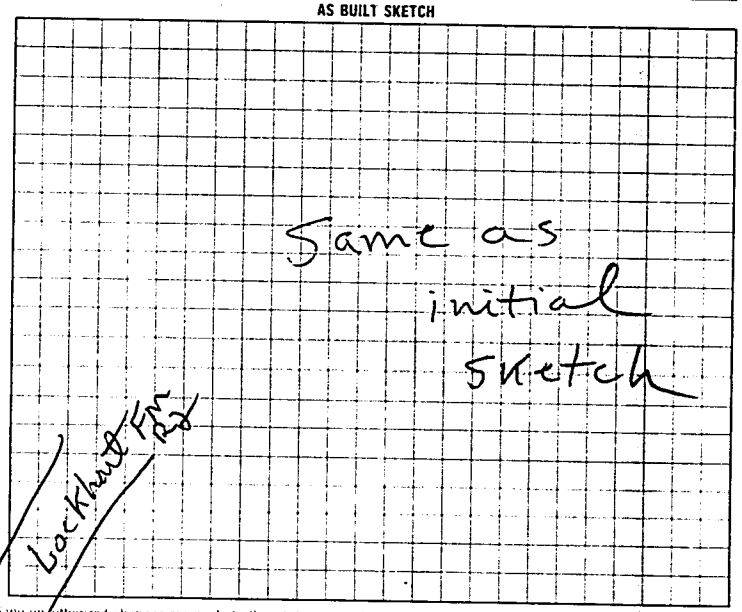

I understand that this permit can be suspended or revoked if any false information is supplied toward securing the permit/any unauthorized changes are made to the site/any unauthorized changes are made in the installation of the system

Signed X David LockHart

Improvement Permit by: Authorization to Construct P.C. Moore date 3-19-96

Existing System Inspection by: P.C. Moore date 3-19-96

Installed by: Donald Lackey

Certificate of Completion by: date

Operation Permit by: P.C. Moore date 3-26-96

WHITE HEALTH DEPT. COPY PINK INSPECTION COPY (INITIAL) GREEN INSPECTION COPY (FINAL) YELLOW OWNER COPY (INITIAL) PINK OWNER COPY (FINAL) GOLD

Authorization to Construct Expires 60 mos from issue

00122 8