CI 704-363-2634

IREDELL COUNTY HEALTH DEPARTMENT

STATESVILLE 704-878-5305 MOORESVILLE 704-664-5281

IMPROVEMENT PERMIT / AUTHORIZATION TO CONSTRUCT / OPERATION PERMIT / EXISTING SYSTEM INSPECTION

PERMIT# 119663 PIN# 4711-65-1867 DATE 7-30-04

OWNER OR CONTRACTOR D & D ENTERPRISES PHONE: Business Home 704-528-6192

ADDRESS PO BOX 5602 STATESVILLE, NC 28687

LOCATION BUFFALO SHOALS WEST, (L) PINEVILLE (R) BRAXTON LOT 17 IN RT

SUBDIVISION PINEVILLE RD EST BLOCK / SECTION II LOT 17 LOT AREA .705AC SITE CLASS. PS DESIGN FLOW 360 L.T.A.R. .3

Septic Tank: 1600 Gallons: STB 1067 Date 10-6-04
Pump Tank: Gallons: PT Date
Pump Make: Model Serial No.
Nitrification Field: No Fields 1 Square Feet EQ=1200' Linear Feet 300'
No Lines 3X100' Trench Width 36" Max Trench Bottom Depth 36" Gravel Depth N/A

☒ New System ☐ Repair System Type: I, II, (III) IV, V, VI
System Description: GRAY 25% REDUCT
Repair System Description: LD 50% REDUCT
Maintenance Agreement Required: ☐ Yes ☒ No

☒ House/Mod. Home No. Bedrooms 3
☐ Mobile Home No. Bathrooms 2
☐ Business No. Employees
☐ Other
☐ Slab ☒ Crawl Space ☐ Basement w/plumbing ☐ Basement wo/plumbing

Water Supply: ☒ Individual ☐ Public ☐ Community


Location of the proposed 12'X26' Pool **addition does not appear to impact the existing on-site septic system.**NOTE:**

Justin Henderson REHS
Date: 4-19-13
ICHD-Environmental Health Division

FLAGGED
HW
DRIVE

Comments:/Conditions: ZABEL FILTER SMACKER
INSTALLED NEW QUICK 4 (HOME TANK HAS 25% REDUCT WITHOUT WARRANTY, SYSTEM V'D OK. LL
BRAX TON

AS BUILT SKETCH

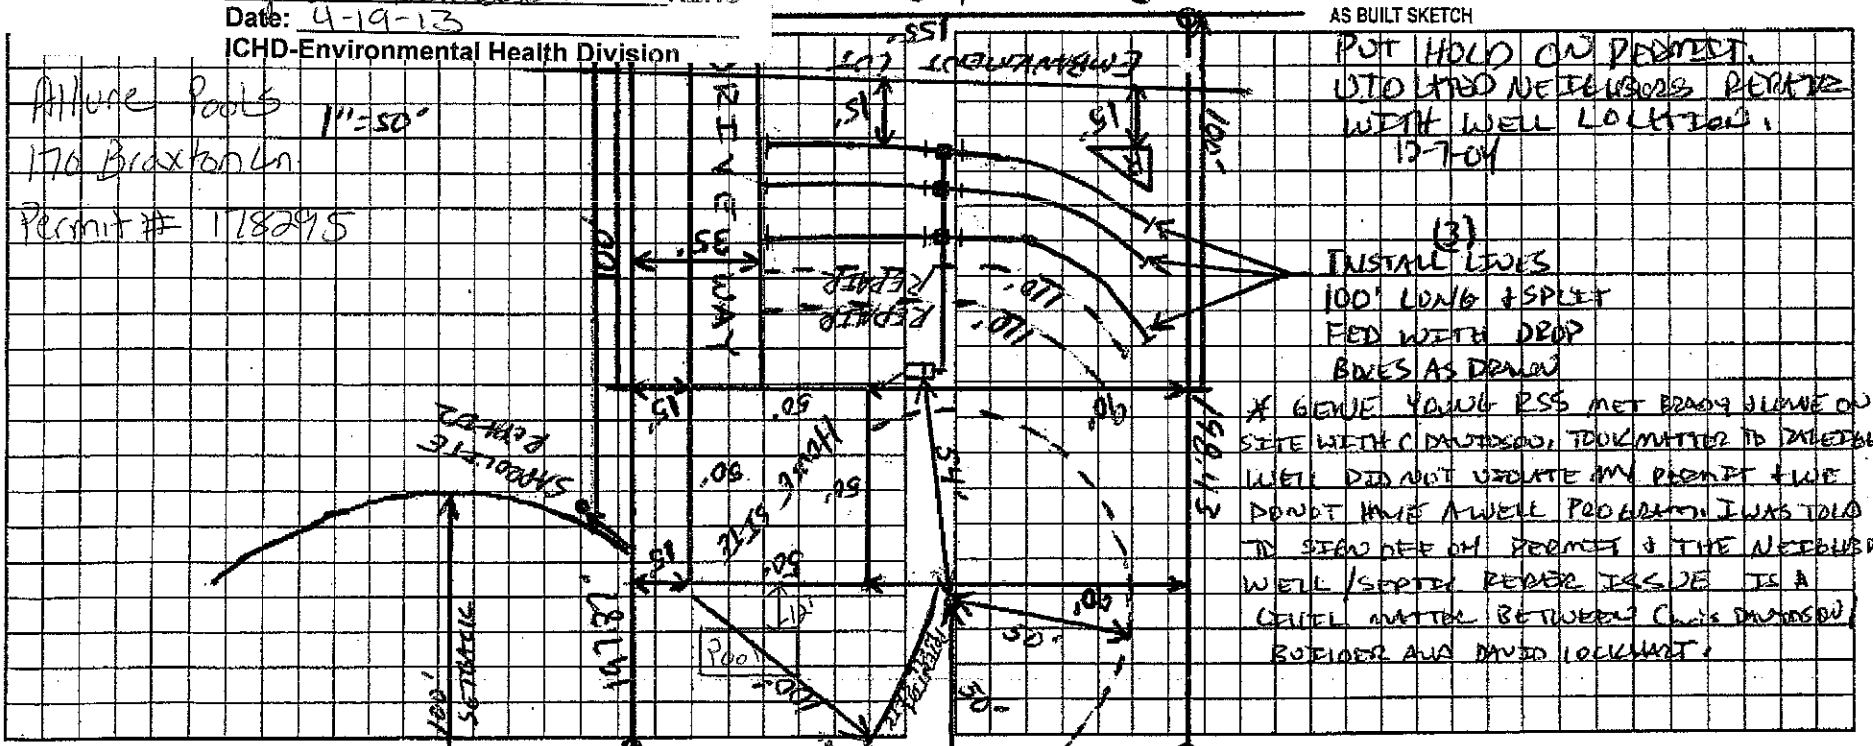

Permit can be suspended or revoked if any false information is supplied toward securing the permit, any unauthorized changes are made to the site, any unauthorized changes are made in the installation of the system. Improvement Permit with plat valid without expiration. Improvement Permit with site plan valid for sixty months. Authorization to construct is valid for a period equal to that of Improvement Permit -- not to exceed sixty months.

Signed: date Installed by: STATESVILLE BACKHOE

Improvement Permit by: JM LHD RS date 7-30-04

Authorization to Construct by: JM LHD RS date 7-30-04

Operation Permit by: JM LHD RS date 3-21-05

Existing System Inspection by: date

HEALTH DEPT. COPY: WHITE OWNER COPY (FINAL): YELLOW OWNER COPY (INITIAL): PINK