Connor Leppard

2:00 wes fytton

IREDELL COUNTY HEALTH DEPARTMENT

STATESVILLE 704-878-5305 MOORESVILLE 704-664-5281

IMPROVEMENT PERMIT / CERTIFICATE OF COMPLETION / OPERATION PERMIT / EXISTING SYSTEM INSPECTION

PROPERTY DESCRIPTION NO. 2351 (OSWW) DATE 5-10-96 TAX MAP NO. 36-B-67 Watershed: ☐ Yes ☑ No

OWNER OR CONTRACTOR Steve Adamczyk PHONE: Business _____ Home 528-6721

ADDRESS 274 Carriage Rd

LOCATION Buffalo Shoals Rd TL Pinville TR Hursley Lane 1st

SUBDIVISION _____ BLOCK / SECTION _____ LOT _____ LOT AREA approx 1acre SITE CLASS. PS DESIGN FLOW 360 d.T.A.R. _____

Septic Tank 1000 Gallons; STB 794 Date 10-17-97

Pump Tank _____ Gallons; PT _____ Date _____

Pump Make: _____ Model _____ Serial No. _____

Nitrification Field: No Fields 1 Square Feet 1200 Linear Feet 400

No Lines 4 Trench Width 36" Max Trench Bottom Depth 36" Gravel Depth 12"

☑ New System ☐ Repair System Type I II III IV V VI

System Description: C.O.V. Gravity

Repair System Description: Pump To Chambers

Maintenance Agreement Required: ☐ Yes ☐ No

☐ Slab ☑ Crawl Space ☐ Basement w/plumbing ☐ Basement wo/plumbing

☐ House/Mod. Home No. Bedrooms 3

☐ Mobile Home No. Bathrooms 2

☐ Business No. Employees _____


☐ Other _____

Water Supply: ☑ Individual ☐ Community ☐ Public


Comments:

Comments:
3 Flow Dividers To split Flow 4 ways

INITIAL SITE SKETCH

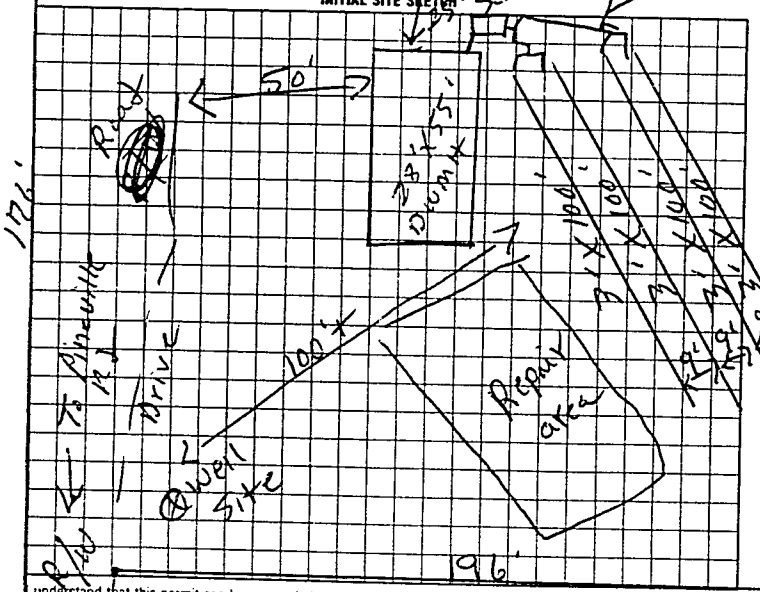

AS BUILT SKETCH

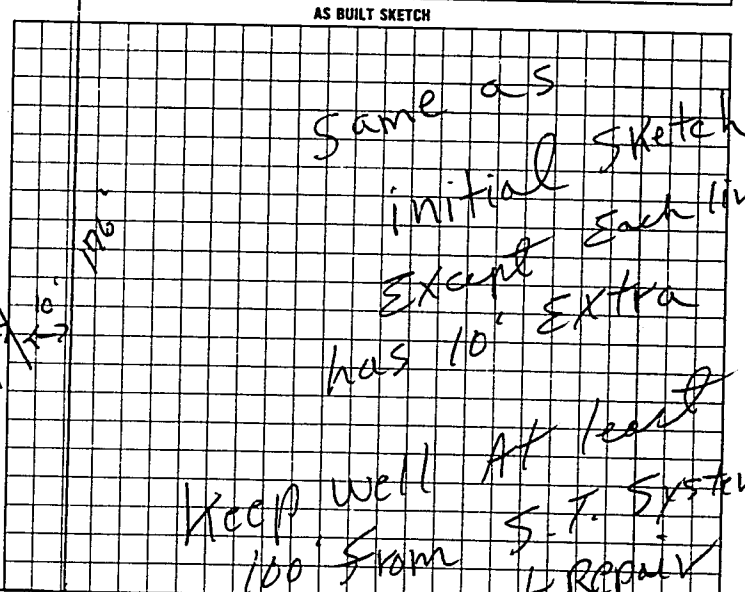

I understand that this permit can be suspended or revoked if any false information is supplied toward securing the permit/any unauthorized changes are made to the site/any unauthorized changes are made in the installation of the system.

Signed: X Stephen Edwards

Improvement Permit by: L.C. Moore date 5-10-96

Authorization Existing System Inspection by: L.C. Moore date 5-10-96

Installed by: Wes Fytton

Certificate of Completion by: _____ date _____

Operation Permit by: L.C. Moore date 12-19-97

to construct HEALTH DEPT. COPY WHITE INS. ECTION COPY (FINAL) GREEN OWNER COPY (FINAL) YELLOW Authorization to Construct INSPECTION COPY (INITIAL) PINK OWNER COPY (INITIAL) GOLD

EXPires 60 mos From issue

6 7 6 2 0 0