IREDELL COUNTY HEALTH DEPARTMENT

STATESVILLE 704-878-5305 MOORESVILLE 704-664-5281

IMPROVEMENT PERMIT / AUTHORIZATION TO CONSTRUCT / OPERATION PERMIT / EXISTING SYSTEM INSPECTION

PERMIT# 106595 PIN# 4711-66-0947 DATE 2/7/03

OWNER OR CONTRACTOR Donna Baggarley PHONE: Business Home (704) 873-6150

ADDRESS 113 Parker Lake Loop Statesville, N. C. 28677

LOCATION Buffalo Shoals Rd (L) Pineville Rd on Left behind Trailer

SUBDIVISION Balls Little Village BLOCK / SECTION — LOT 6 LOT AREA .69 Acre SITE CLASS. P5 DESIGN FLOW 360 L.T.A.R. .30 g.p.d/ft2

Septic Tank: Ex 1000 Gallons; STB 1012 Date 4-14-02

Pump Tank: _____ Gallons; PT _____ Date _____

Pump Make: _____ Model _____ Serial No. _____

Nitrification Field: No Fields 1 Square Feet Equ to 440 Linear Feet 110'

No Lines 1@110' Trench Width 36" Max Trench Bottom Depth 24" Gravel Depth NA

[X] New System [ ] Repair System Type: I, II, (III) IV, V, VI Shallow

System Description: Gravity, 25% Reduction

Repair System Description: ~~Pump from tank, 25% Reduction Shallow~~

Maintenance Agreement Required: [ ] Yes [X] No

[ ] House/Mod. Home No. Bedrooms 3

[X] Mobile Home No. Bathrooms 2

[ ] Business No. Employees ____

[ ] Other _____


[ ] Slab [X] Crawl Space [ ] Basement w/plumbing [ ] Basement wo/plumbing

Water Supply: [X] Individual [ ] Public [ ] Community


Comments/Conditions: (1) Keep line shallow because of saprolite + wells in area (2) Reset or replace distribution box if necessary (3) Keep well minimum of 100 ft from septic system. (4) Okay to install septic line in Power line R-O-W.

Comments/Conditions: (Repair - Pump; LPP) - 4 Infiltrator Chambers Installed

INITIAL SITE SKETCH (Scale 1"=50')

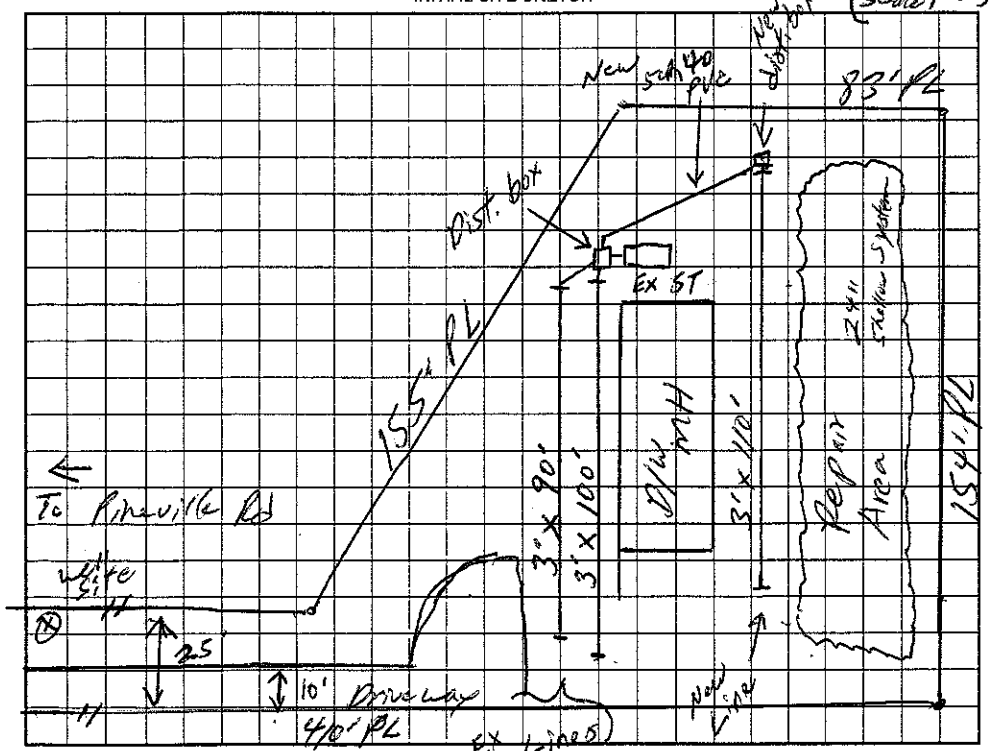

AS BUILT SKETCH (Not to Scale)

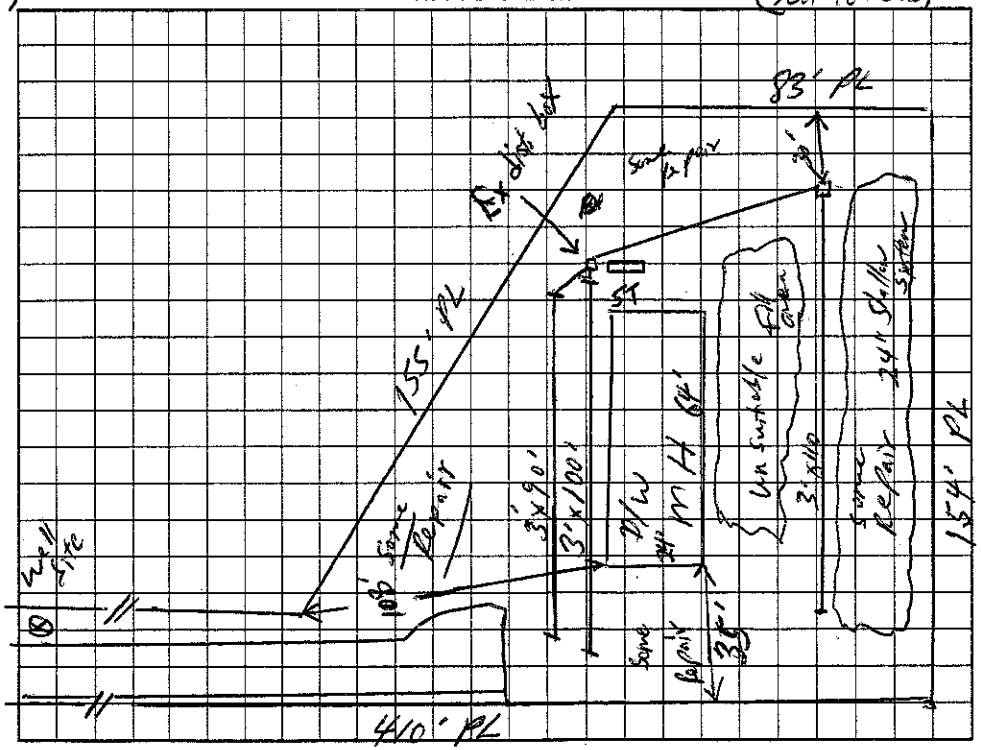

Permit can be suspended or revoked if any false information is supplied toward securing the permit/any unauthorized changes are made to the site/any unauthorized changes are made in the installation of the system. Improvement Permit with plat valid without expiration. Improvement Permit with site plan valid for sixty months. Authorization to Construct is valid for a period equal to that of Improvement Permit – not to exceed sixty months.

Signed: Donna J. Baggarley date 2/7/03

Improvement Permit by: William O. Johnson date 2/7/03

Authorization to Construct by: William O. Johnson date 2/7/03

Installed by: C + M Enterprises

Operation Permit by: William O. Johnson date 4/29/03

Existing System Inspection by: _____ date _____

HEALTH DEPT. COPY: WHITE OWNER COPY (FINAL): YELLOW OWNER COPY (INITIAL): PINK