IREDELL COUNTY HEALTH DEPARTMENT

STATESVILLE 704-878-5305 130.00 Pd MOORESVILLE 704-664-5281

IMPROVEMENT PERMIT / AUTHORIZATION TO CONSTRUCT / OPERATION PERMIT / EXISTING SYSTEM INSPECTION

PERMIT# 106595 PIN# 4711660947 DATE 6/19/2002

OWNER OR CONTRACTOR Donna Baggarley PHONE: Business _____ Home 873-6150

ADDRESS 113 Parker Lake Dr Statesville, NC 28677

LOCATION Buffalo Shoals Rd. TL Pineville Rd on left behind trailer — 110 Pineville Rd.

SUBDIVISION Balls Little Village BLOCK / SECTION _____ LOT 60 LOT AREA .64 Acre SITE CLASS PS DESIGN FLOW 240gpd L.T.A.R. .3 - .325

Septic Tank: 1000 Gallons; STB 1012 Date 4-14-02

Pump Tank: _____ Gallons; PT _____ Date _____

Pump Make: _____ Model _____ Serial No. _____

Nitrification Field: No Fields 1 Square Feet 600' Linear Feet 200-190

No Lines 2@100' Trench Width 36" Max Trench Bottom Depth 36" Gravel Depth N/A

☒ New System ☐ Repair System Type: I, II, III, IV, V, VI

System Description: Gravity - 25% Reduction

Repair System Description: Pump Panel Blk

Maintenance Agreement Required: ☐ Yes ☒ No Initially Not

☐ House/Mod. Home ☒ Mobile Home ☐ Business ☐ Other


No. Bedrooms 2 No. Bathrooms 2 No. Employees ____

☐ Slab ☒ Crawl Space ☐ Basement w/plumbing ☐ Basement wo/plumbing

Water Supply: ☒ Individual ☐ Public ☐ Community

Comments:/Conditions: Keep Septic System 10' from PL 5' from house and at least 50' from any well. Stay out of ROW with Septic System.

INITIAL SITE SKETCH Scale 1:50

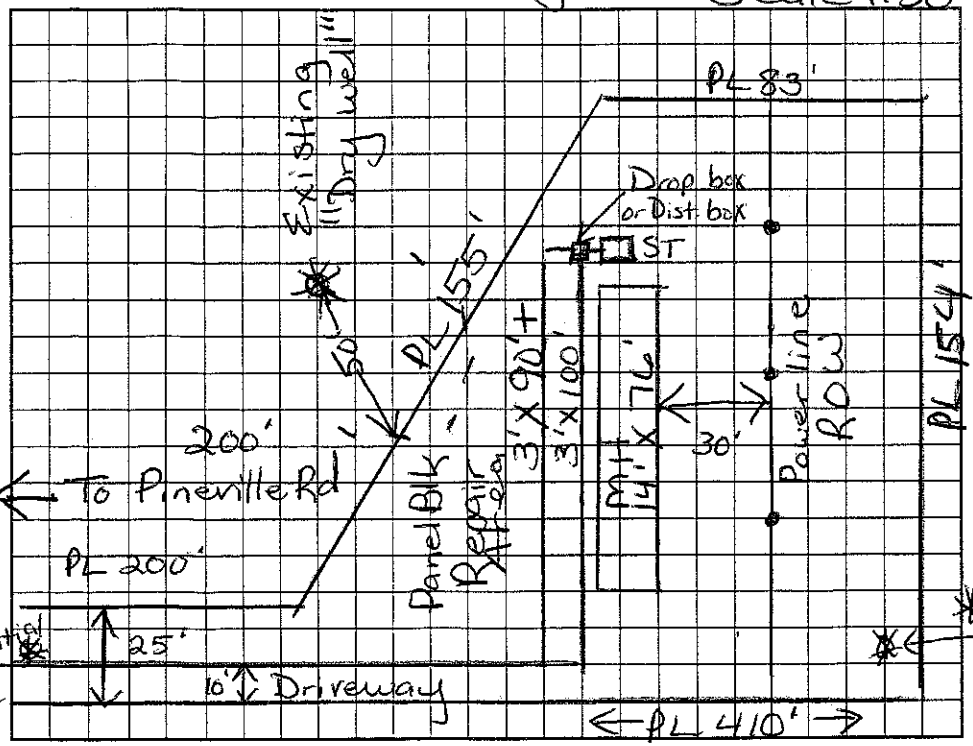


Comments:/Conditions: Okay to use "Drop box" or Dist. box. Do Not cut house pad area down anymore or drainfield will have to be "pumped". Keep well 25' from house, 50' from any Septic and out of ROW Keep water line 10' from Septic.

- 190ft of Infiltrator Chamber Installed
- Installed more than 36" deep because of Incorrect Footer design.

AS BUILT SKETCH

Installed as Shown

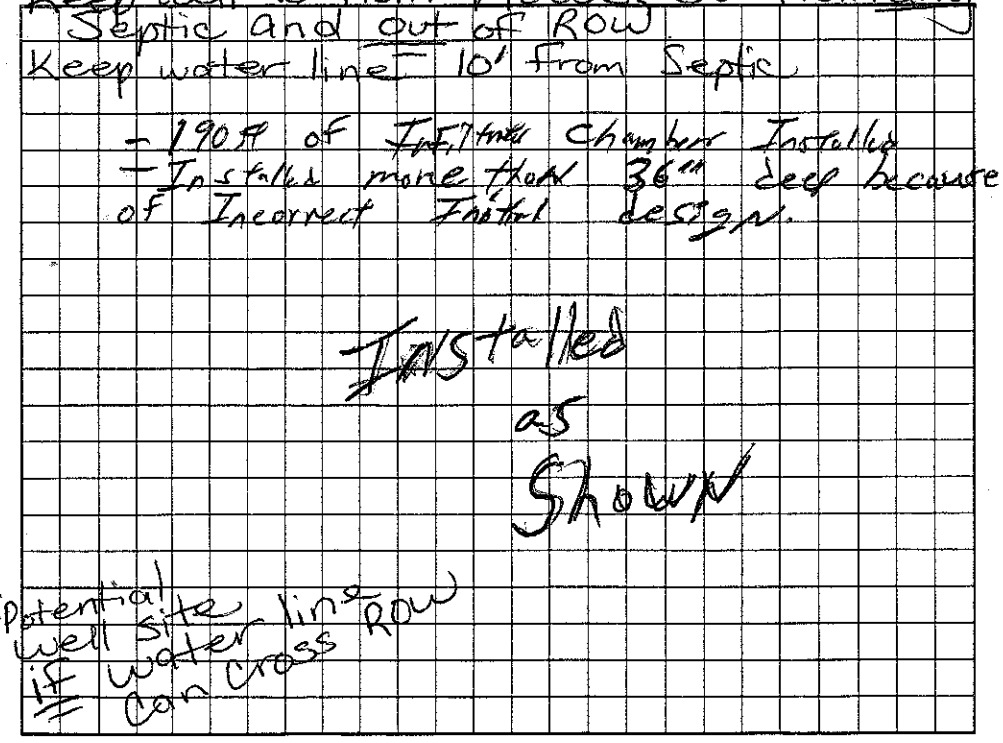

Permit can be suspended or revoked if any false information is supplied toward securing the permit/any unauthorized changes are made to the site/any unauthorized changes are made in the installation of the system. Improvement Permit with plat valid without expiration. Improvement Permit with site plan valid for sixty months. Authorization to Construct is valid for a period equal to that of Improvement Permit – not to exceed sixty months.

Signed: Donna J. Baggarley date _____ Installed by: Forrest Shuford

Improvement Permit by: Maria H. Dobson RS date 6/19/2002 Operation Permit by: William G. Johnson date 6/26/02

Authorization to Construct by: Maria H. Dobson RS date 6/19/2002 Existing System Inspection by: _____ date _____

HEALTH DEPT. COPY: WHITE OWNER COPY (FINAL): YELLOW OWNER COPY (INITIAL): PINK