*THIS PERMIT REPLACES REVOKED PERMIT, ISSUED 1-17-02

IREDELL COUNTY HEALTH DEPARTMENT

STATESVILLE 704-878-5305 MOORESVILLE 704-664-5281

IMPROVEMENT PERMIT / AUTHORIZATION TO CONSTRUCT / OPERATION PERMIT / EXISTING SYSTEM INSPECTION

PERMIT# 103913 PIN# 4711-66-3466 DATE 04/08/03

OWNER OR CONTRACTOR D+D ENTERPRISES OF IREDELL PHONE: Business 704-363-2634 Home 704-528-6192

ADDRESS P.O. BOX 5602 STATESVILLE, NC 28687

LOCATION BUFFALO SHOALS RD.; (L) PINEVILLE RD., (R) BRAXTON, PROPERTY ON RIGHT MIDWAY DOWN ROAD,

SUBDIVISION PINEVILLE EST. BLOCK / SECTION II LOT 4 LOT AREA 0.7 ACRES SITE CLASS. PS DESIGN FLOW 360 GPD L.T.A.R. 0.30 GPD/FT²

Septic Tank: 1,000 Gallons; STB 312 Date 03/02/03
Pump Tank: ____ Gallons; PT ____ Date ____
Pump Make: ____ Model ____ Serial No. ____
Nitrification Field: No Fields 1 Square Feet EQ+1,200 Linear Feet 200
No Lines 4@50' Trench Width 24" Max Trench Bottom Depth 36" Gravel Depth N/A

[X] New System [ ] Repair System Type: I, II, III, IV, V, VI
System Description: 50% REDUC.; GRAVITY
Repair System Description: 50% REDUC., LOW PRES.
Maintenance Agreement Required: [ ] Yes [X] No

[X] House/Mod. Home No. Bedrooms 3
[ ] Mobile Home No. Bathrooms 2
[ ] Business No. Employees ____
[ ] Other ____

[ ] Slab [X] Crawl Space [ ] Basement w/plumbing [ ] Basement wo/plumbing


Water Supply: [X] Individual [ ] Public [ ] Community
WELL

Comments/Conditions: (1) INSTALL SYSTEM USING 11 PANELS PER LINE (44 PANELS TOTAL TO EQUAL 200') (2) KEEP SYSTEM 100' PLUS FROM WELLS (15A NCAC 18A.1956(4)(g))


Comments/Conditions: (3) KEEP LINES 15' PLUS FROM FRONT EMBANKMENT.

*SEPTIC TANK INSTALLED USING ZABEL FILTER & TANK MARKER.

INITIAL SITE SKETCH

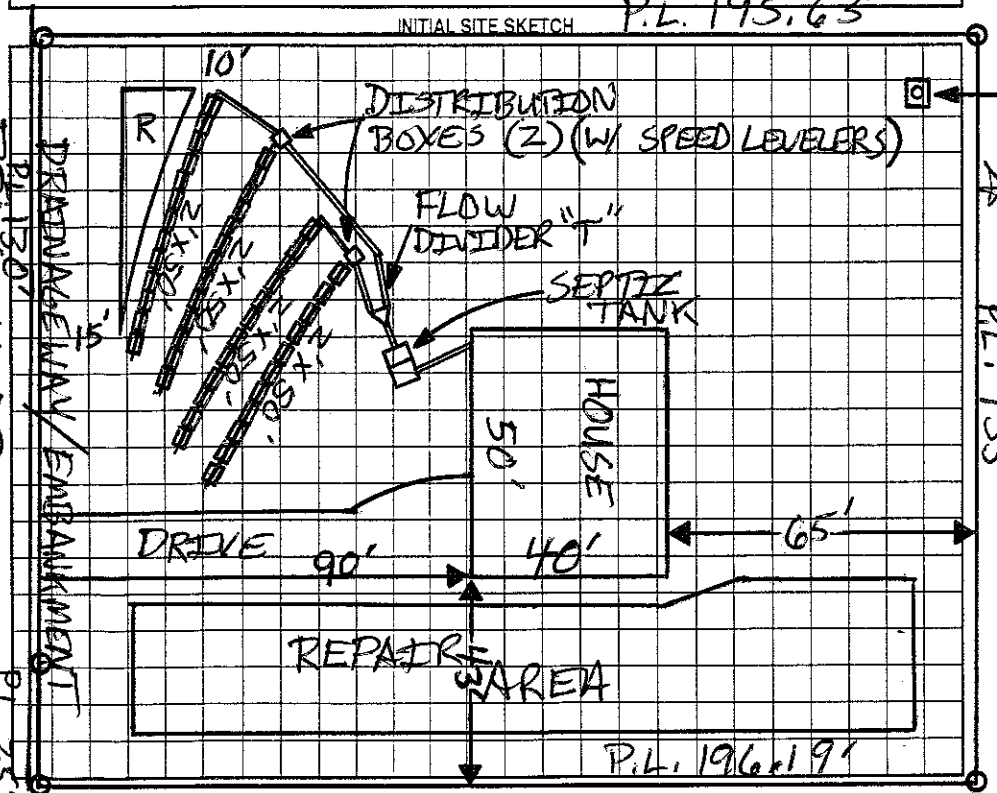

AS BUILT SKETCH

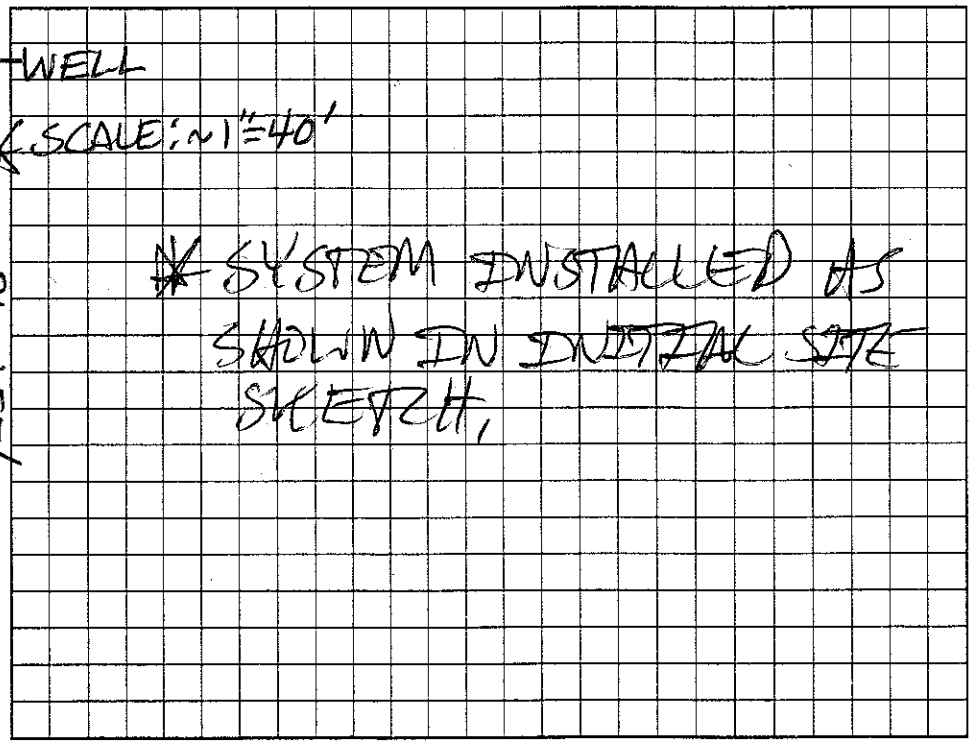

Permit can be suspended or revoked if any false information is supplied toward securing the permit/any unauthorized changes are made to the site/any unauthorized changes are made in the installation of the system. Improvement Permit with plat valid without expiration. Improvement Permit with site plan valid for sixty months. Authorization to Construct is valid for a period equal to that of Improvement Permit – not to exceed sixty months.

Signed: ____ date 4/10/03 Installed by: LANCE LINGLE

Improvement Permit by: Patrick Mitchell date 04/08/03 Operation Permit by: Patrick Mitchell date 04/17/03

Authorization to Construct by: Patrick Mitchell date 04/08/03 Existing System Inspection by: ____ date ____

HEALTH DEPT. COPY: WHITE OWNER COPY (FINAL): YELLOW OWNER COPY (INITIAL): PINK