IREDELL COUNTY HEALTH DEPARTMENT

STATESVILLE 704-878-5305 MOORESVILLE 704-664-5281

IMPROVEMENT PERMIT / AUTHORIZATION TO CONSTRUCT / OPERATION PERMIT / EXISTING SYSTEM INSPECTION

PERMIT# 100926 PIN# 4711-66-4766 DATE 2/23/01

OWNER OR CONTRACTOR DHD Estates PHONE: Business (704) 528-5805 Home —

ADDRESS P.O. Box 252 Troutman, N.C. 28166

LOCATION Buffalo Shoals Rd to Brew Rd on Brawley Rd. Lot on Rt.

SUBDIVISION Pinnacle Pt Estates BLOCK / SECTION I LOT 2 LOT AREA .69 Acres SITE CLASS PS DESIGN FLOW 360 L.T.A.R. .35

Septic Tank: 1000 Gallons: STB 372 Date 3-6-2001 ☒ New System ☐ Repair System Type: I, II, III, IV, V, ~~Conventional~~ ☒ House/Mod. Home No. Bedrooms 3

Pump Tank: — Gallons: PT — Date — System Description: Gravity ~~Conventional~~ ☐ Mobile Home No. Bathrooms 2

Pump Make: — Model equivalent Serial No. 258' Repair System Description: Pump, 50% Reduction ☐ Business No. Employees —

Nitrification Field: No Fields 1 Square Feet 1029 Linear Feet [redacted] Maintenance Agreement Required: ☐ Yes ☐ No ☐ Other —


No Lines 3@86' Trench Width 36" Max Trench Bottom Depth 36" Gravel Depth NA ☐ Slab ☒ Crawl Space ☐ Basement w/plumbing ☐ Basement wo/plumbing

Water Supply: ☒ Individual ☐ Public ☐ Community


Comments/Conditions: 1) Keep roots from wells

Comments/Conditions: Health Dept approval to add cardboard 35' Arc + Change System Type - Label filter to installed - Septic Tank Marker Installed

INITIAL SITE SKETCH 195' PL

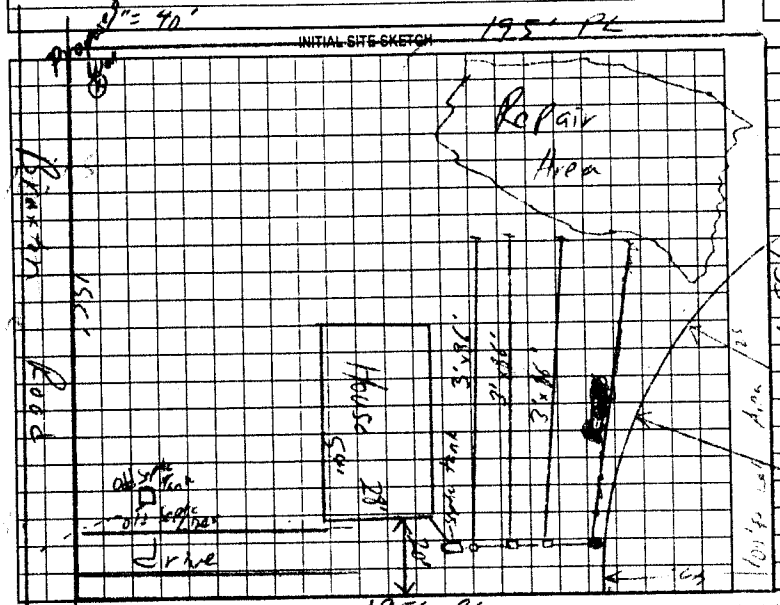

AS BUILT SKETCH (Not to Scale)

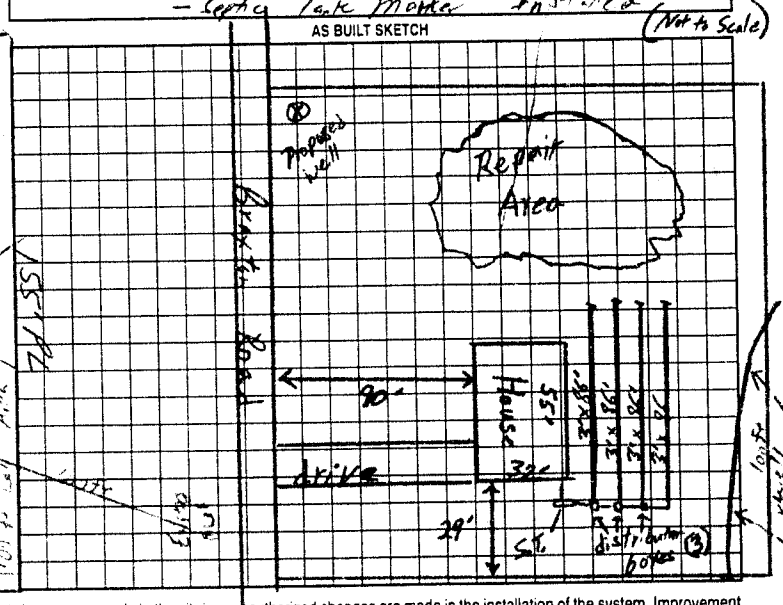

Permit can be suspended or revoked if any false information is supplied toward securing the permit/any unauthorized changes are made to the site/any unauthorized changes are made in the installation of the system. Improvement Permit with plat valid without expiration. Improvement Permit with site plan valid for sixty months. Authorization to Construct is valid for a period equal to that of Improvement Permit – not to exceed sixty months.

Signed: [signature] date —

Improvement Permit by: William E. Johnson date 2/23/01

Authorization to Construct by: William E. Johnson date 2/23/01

Installed by: Wesley Williams

Operation Permit by: William E. Johnson date 9/24/01

Existing System Inspection by: — date —

HEALTH DEPT. COPY WHITE OWNER COPY (FINAL) YELLOW OWNER COPY (INITIAL) PINK