IREDELL COUNTY HEALTH DEPARTMENT

STATESVILLE 704-878-5305 CF MOORESVILLE 704-664-5281

IMPROVEMENT PERMIT / AUTHORIZATION TO CONSTRUCT / OPERATION PERMIT / EXISTING SYSTEM INSPECTION

PERMIT# 112822 PIN# 4711 ~~65 8051. 4~~ Lot 5234 DATE 8/22/03

OWNER OR CONTRACTOR CHRIS DAVIDSON PHONE: Business 528-6192 Home

ADDRESS PO Box 5602 STATESVILLE NC 28677

LOCATION OMR - TR BUFFALO SHOALS TOWARD LAKE - TL PINEVILLE - TR BRAXTON - LOT ON LT.

SUBDIVISION PINEVILLE ESTATES BLOCK / SECTION LOT 9 LOT AREA SITE CLASS. PS DESIGN FLOW 360GPD L.T.A.R. .3600/FT2

Septic Tank: 1000 Gallons; STB 1001 Date 7-4-04
Pump Tank: 1000 Gallons; PT 274 Date 7-2-04
Pump Make: ZOELLER Model E498B Serial No SER 98-00005
Nitrification Field: No Fields 1 Square Feet 400 Linear Feet 200
No Lines 4@50' Trench Width 24" Max Trench Bottom Depth 36" Gravel Depth N/A

☑ New System ☐ Repair System Type: I, II, III, IV, V, VI
System Description: PUMP PANEL
Repair System Description: LP PANEL
Maintenance Agreement Required: ☐ Yes ☑ No

☑ House/Mod. Home No. Bedrooms 3
☐ Mobile Home No. Bathrooms 3
☐ Business No. Employees
☐ Other


Water Supply: ☑ Individual ☐ Public ☐ Community

☐ Slab ☑ Crawl Space ☐ Basement w/plumbing ☐ Basement wo/plumbing

Comments/Conditions: 5' Separation Minimum Must Be Maintained between Sundeck (if built) and Septic/Pump Tank

Comments/Conditions: ZABEL FILTER & MARKER, V'D TANKS 9-10-04 LC
5'
BUILDER OK'D TANK MOVEMENTS OUT OF SWELL

INITIAL SITE SKETCH 1"=60'

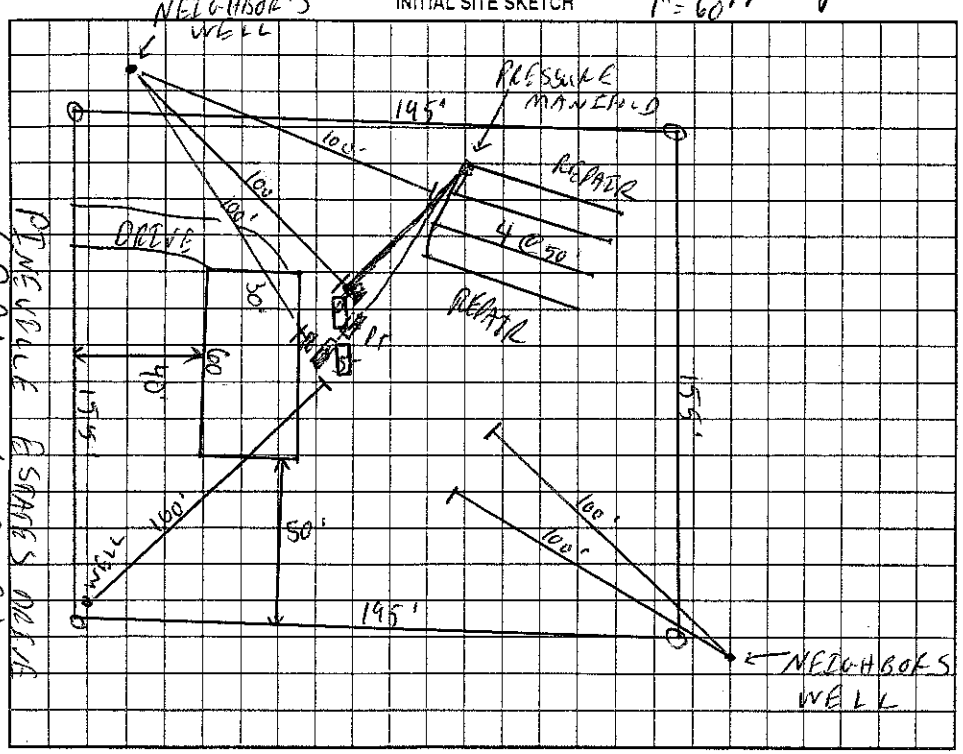

AS BUILT SKETCH

V'D & TWO PRESSURE MANIFOLDS ELEVATION 9-13-04
V'D ELEVATION OF PUMP TANK 9-20-04

Permit can be suspended or revoked if any false information is supplied toward securing the permit/any unauthorized changes are made to the site/any unauthorized changes are made in the installation of the system. Improvement Permit with plat valid without expiration. Improvement Permit with site plan valid for sixty months. Authorization to Construct is valid for a period equal to that of Improvement Permit – not to exceed sixty months.

*Signed: date 9/2/03 Installed by: SAMMY SHUMAKER

Improvement Permit by: RS date 8/22/03 Operation Permit by: date 9-20-04

Authorization to Construct by: date 3/30/04 Existing System Inspection by: date

HEALTH DEPT. COPY: WHITE OWNER COPY (FINAL): YELLOW OWNER COPY (INITIAL): PINK