IREDELL COUNTY HEALTH DEPARTMENT

STATESVILLE 704-878-5305 CI MOORESVILLE 704-664-5281

IMPROVEMENT PERMIT / AUTHORIZATION TO CONSTRUCT / OPERATION PERMIT / EXISTING SYSTEM INSPECTION

PERMIT# 103915 PIN# 4711-66-5398 DATE 01-17-02

OWNER OR CONTRACTOR D&D ENTERPRISES OF IREDELL LLC PHONE: Business 704-365-2634 Home 704-528-6192

ADDRESS PO BOX 5602 STATESVILLE NC 28687

LOCATION BUFFALO SHOALS, (C) PINEVILLE RD, (R) BRAXTON DR, AT END ON LEFT

SUBDIVISION PINEVILLE RD EST BLOCK / SECTION ____ LOT 8 LOT AREA .7 SITE CLASS. PS DESIGN FLOW 360 L.T.A.R. .3

Septic Tank: 1000' Gallons; STB 312 Date 3-29-03
Pump Tank: ____ Gallons; PT ____ Date ____
Pump Make: ____ Model ____ Serial No. ____
Nitrification Field: No Fields 1 Square Feet EQ=1200' Linear Feet 300'
No Lines 6 x 50' Trench Width 36" Max Trench Bottom Depth 36" Gravel Depth N/A

[X] New System [ ] Repair System Type: I, II, III, IV, V, VI
System Description: GRAY 25% REDUCTION
Repair System Description: LOW PRESSURE PANELS
Maintenance Agreement Required: [ ] Yes [X] No


[X] House/Mod. Home No. Bedrooms 3
[ ] Mobile Home No. Bathrooms 2
[ ] Business No. Employees ____
[ ] Other ____
[ ] Slab [X] Crawl Space [ ] Basement w/plumbing [ ] Basement wo/plumbing

Water Supply: [X] Individual [ ] Public [ ] Community WELL


Comments/Conditions: (1) KEEP REAR DECK 5' OFF OF I SYSTEM AREA; MAY HAVE TO SLIDE HOUSE FORWARD MORE TO ACCOMADATE THIS. (2) MAINTAIN SETBACKS (3) USE FLOW DIVIDER TEE & INSTALL LINES ON CONTOURS

Comments/Conditions: (3) DUE TO SAPROLITE KEEP INITIAL & REPAIR OF SYSTEM 100' away from wells. (4) GARAGE MUST NOT BE FULL LENGTH OF HOUSE TO ENABLE STUBOUT TO STAY AS DRAWN

INITIAL SITE SKETCH 1"=50'

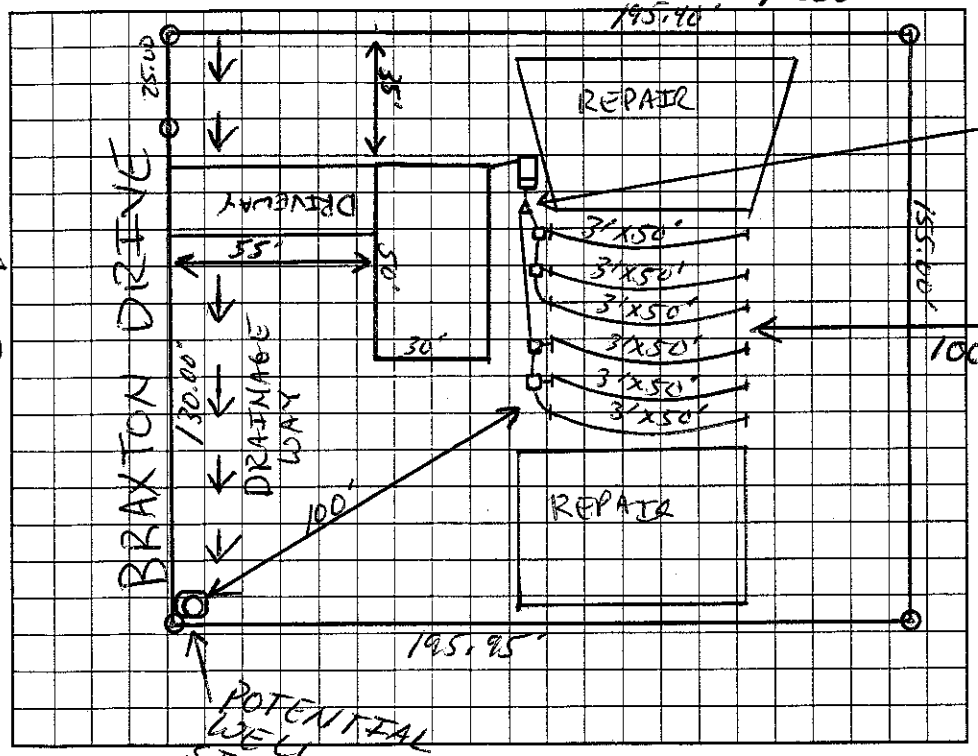

AS BUILT SKETCH

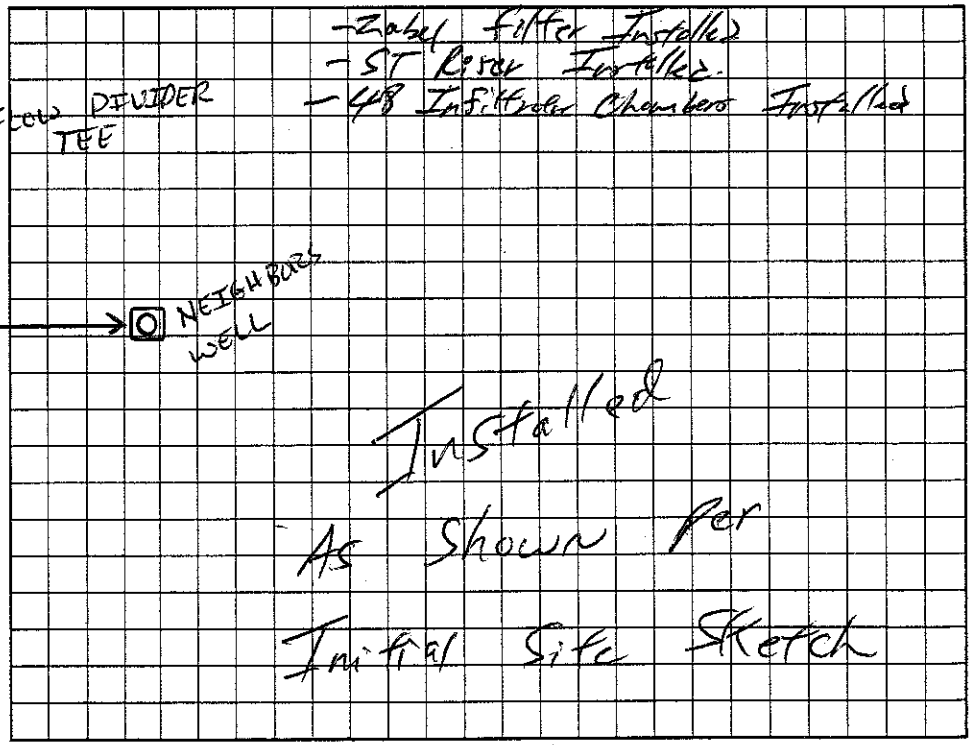

Permit can be suspended or revoked if any false information is supplied toward securing the permit/any unauthorized changes are made to the site/any unauthorized changes are made in the installation of the system. Improvement Permit with plat valid without expiration. Improvement Permit with site plan valid for sixty months. Authorization to Construct is valid for a period equal to that of Improvement Permit – not to exceed sixty months.

Signed: Neil Kale date 1-18-02 Installed by: Lance Lingle

Improvement Permit by: [signature] date 01-17-02 Operation Permit by: William O. Johnson date 8/29/03

Authorization to Construct by: [signature] date 01-17-02 Existing System Inspection by: ____ date ____

HEALTH DEPT. COPY: WHITE OWNER COPY (FINAL): YELLOW OWNER COPY (INITIAL): PINK

Change out front & Deer Tunnel