# IREDELL COUNTY HEALTH DEPARTMENT

STATESVILLE 704-878-5305 ✓ MOORESVILLE 704-664-5281

## IMPROVEMENT PERMIT / AUTHORIZATION TO CONSTRUCT / OPERATION PERMIT / EXISTING SYSTEM INSPECTION

PERMIT# 100 925 PIN# 4911-66-5900

OWNER OR CONTRACTOR D70 Enterprises PHONE: Business (704) 528-5808 DATE 7/23/01

ADDRESS P.O. Box 252 Troutman N.C. 28166 Home cell (704) 363-2634

LOCATION Buffalo Shoals Rd on Fiorville Road, Rt on Brayton Rd, 1st Lot on Right

SUBDIVISION Lincoln Rd Estates BLOCK / SECTION I LOT 1 LOT AREA .69 SITE CLASS V5 DESIGN FLOW 360 L.T.A.R.

Septic Tank: 1000 Gallons; STB Date

Pump Tank: Gallons; PT Date

Pump Make: Model Serial No.

Nitrification Field: No Fields 1 Square Feet 1200 Linear Feet 400

No Lines 4 @ 100 Trench Width 36" Max Trench Bottom Depth 36" Gravel Depth 12"

X New System ☐ Repair System Type: ☐ I ☐ II ☐ III ☐ IV ☐ V ☐ VI

System Description: Gravity, Conventional

Repair System Description: Pump, 50% Reduction

Maintenance Agreement Required: ☐ Yes ☐ No

☐ Slab X Crawl Space ☐ Basement w/plumbing ☐ Basement wo/plumbing

X House/Mod. Home No. Bedrooms 3

☐ Mobile Home No. Bathrooms 2

☐ Business No. Employees


☐ Other

Water Supply: X Individual ☐ Public ☐ Community


Comments/Conditions: ① Keep System 100ft From Wells

Comments/Conditions:
- Label Filter Installed
- Polylok Effluent Filter Installed
- Septic Tank Marker Installed

INITIAL SITE SKETCH

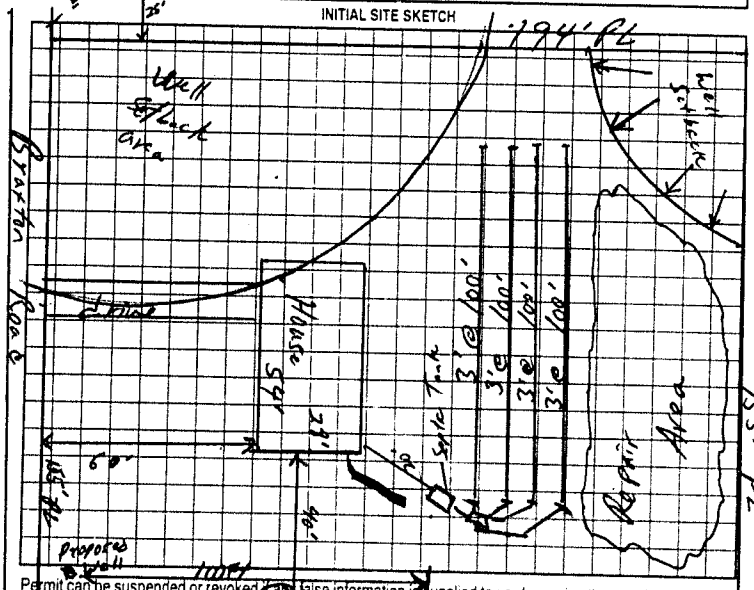


AS BUILT SKETCH

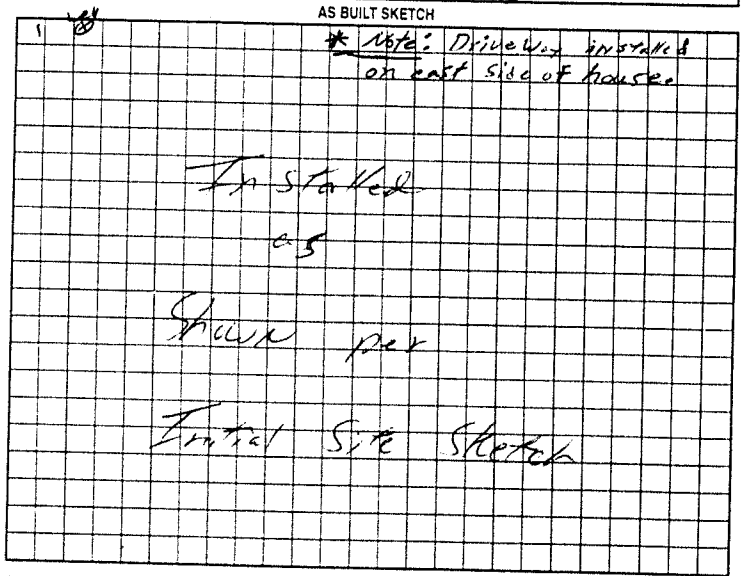


Permit can be suspended or revoked if any false information is supplied toward securing the permit/any unauthorized changes are made to the site/any unauthorized changes are made in the installation of the system. Improvement Permit with plat valid without expiration. Improvement Permit with site plan valid for sixty months. Authorization to Construct is valid for a period equal to that of Improvement Permit – not to exceed sixty months.

Signed: date

Improvement Permit by: William E. Johnson date 7/23/01

Authorization to Construct by: William E. Johnson date 7/23/01

Installed by: Lance Cingle

Operation Permit by: William E. Johnson date 12/4/01

Existing System Inspection by: date

HEALTH DEPT COPY WHITE OWNER COPY (FINAL) YELLOW OWNER COPY (INITIAL) PINK