posted - OR 7-20-01

IREDELL COUNTY HEALTH DEPARTMENT

STATESVILLE 704-878-5305 MOORESVILLE 704-664-5281

IMPROVEMENT PERMIT / AUTHORIZATION TO CONSTRUCT / OPERATION PERMIT / EXISTING SYSTEM INSPECTION

PERMIT# 90428 PIN# 4711 66 3180 DATE 7-20-00

OWNER OR CONTRACTOR D + D Enterprizes PHONE: Business 528 6193 Home

ADDRESS PO Box 5602 Troutman N.C.

LOCATION Buffalo Shoals Rd To Pineville TR Braxton 3rd lot left.

SUBDIVISION Pineville Rt Est. BLOCK / SECTION LOT 7 LOT AREA .69 acres SITE CLASS PS DESIGN FLOW 360 gpd L.T.A.R. 3

Septic Tank: 1000 Gallons; STB 979 Date 1-5-01
Pump Tank: Gallons; PT Date
Pump Make: Model Serial No.
Nitrification Field: No Fields 1 Square Feet 1200 Linear Feet 400
No Lines 5 Trench Width 36" Max Trench Bottom Depth 36" Gravel Depth 12"

☑ New System ☐ Repair System Type: I II III IV V VI
System Description: Conv. Gravity
Repair System Description: 25% Reduction
Maintenance Agreement Required: ☐ Yes ☐ No

☑ House/Mod. Home No. Bedrooms 3
☐ Mobile Home No. Bathrooms 2
☐ Business No. Employees
☐ Other

☐ Slab ☑ Crawl Space ☐ Basement w/plumbing ☐ Basement wo/plumbing

Water Supply: ☑ Individual ☐ Public ☐ Community


Comments/Conditions:

194'


Comments/Conditions:

- Zoeller Filter Installed
- Septic Tank marker Installed

INITIAL SITE SKETCH

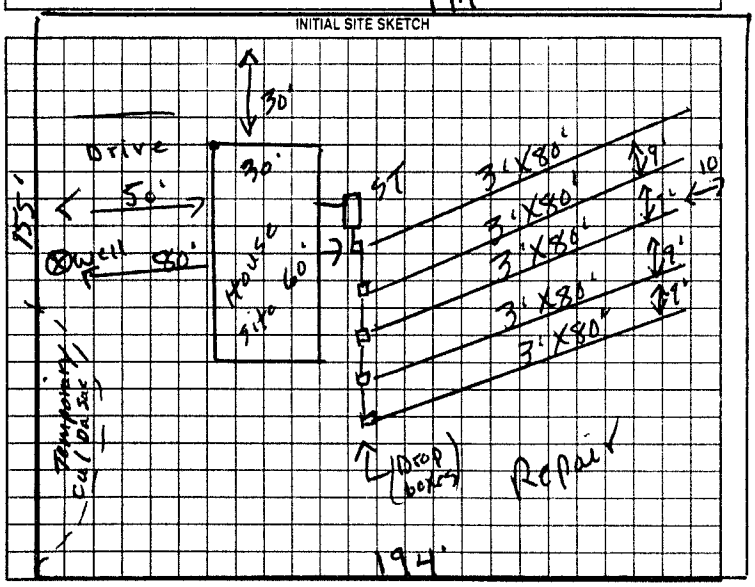

AS BUILT SKETCH

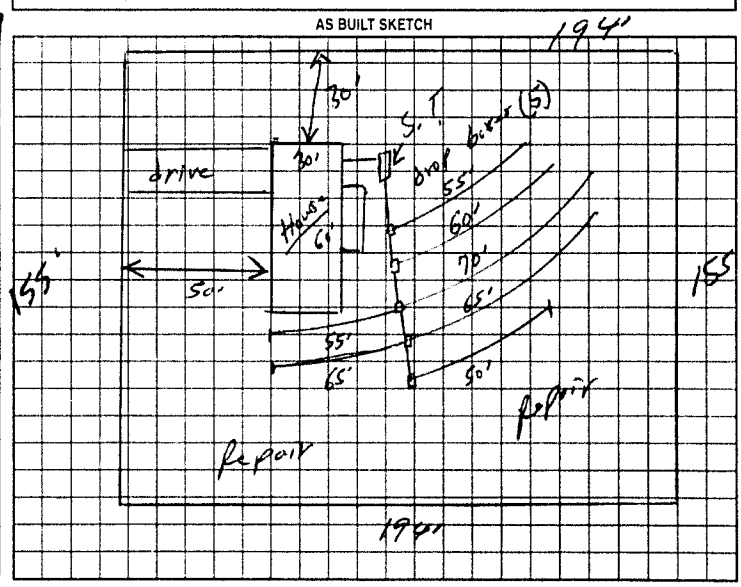

Permit can be suspended or revoked if any false information is supplied toward securing the permit/any unauthorized changes are made to the site/any unauthorized changes are made in the installation of the system. Improvement Permit with plat valid without expiration. Improvement Permit with site plan valid for sixty months. Authorization to Construct is valid for a period equal to that of Improvement Permit – not to exceed sixty months.

Signed: [signature] date

Installed by: Lance Cingle

Improvement Permit by: D. C. Moore date 7-20-00

Operation Permit by: William G. Lohman date 9/19/01

Authorization to Construct by: D. C. Moore date 7-20-00

Existing System Inspection by: date

HEALTH DEPT. COPY: WHITE OWNER COPY (FINAL): YELLOW OWNER COPY (INITIAL): PINK