IREDELL COUNTY HEALTH DEPARTMENT

Statesville Office (704) 878-5305 Mooresville Office (704) 660-3625 PERMIT # 218180

IMPROVEMENT PERMIT / AUTHORIZATION TO CONSTRUCT / OPERATION PERMIT / EXISTING SYSTEM

PIN # 4711669867 V

APPLICANT: Lisa Holzworth APPLICANT ADDRESS: 160 Pineville Rd.

SITE ADDRESS: 160 Pineville Rd. PHONE: 704-658-7508 ALT. PHONE: N/A

SITE DIRECTIONS: Buffalo Shoals Rd. TL Pineville Rd. Property on Right just before Limbo Rock

SUBDIVISION: Christopher Davidson SECTION: N/A LOT # 1 LOT AREA: 1.3 acres DESIGN FLOW: 240gpd L.T.A.R.: 0.25

Septic Tank 1000 (gal) STB 1012 Date 1-3-15
Pump Tank w/pt (gal) PT N/S Date w/pt
Pump Make N/S Model Tuthill Serial # BFV
Nitrification Fields 1 # Lines 3 Linear Ft: 218'
Trench Width 36" Max. Trench Bottom Depth 33" Gravel Depth N/A


☐ New System ☑ Repair ☐ Expansion System Type: I II III IV V VI
System Description: 25% Reduction
Repair System Description:
Maintenance Agreement Required: ☐ YES ☑ NO
☑ GRAVITY ☐ PRESSURE

☑ Residence ☐ Business ☐ Other ☐ Slab ☐ Basement w/plumbing
No. Bedrooms 2 No. Persons 4 No. Employees ☑ Crawl Space

Water Supply: ☑ Private ☐ Public ☐ Community ☐ Basement w/o plumbing

Comments / Conditions: Pump & crush existing septic tank. Install new septic tank @ location shown below. Install a 25% Reduction System on contour with serial distribution. Install trench bottom @ 33" high side

INITIAL SITE SKETCH

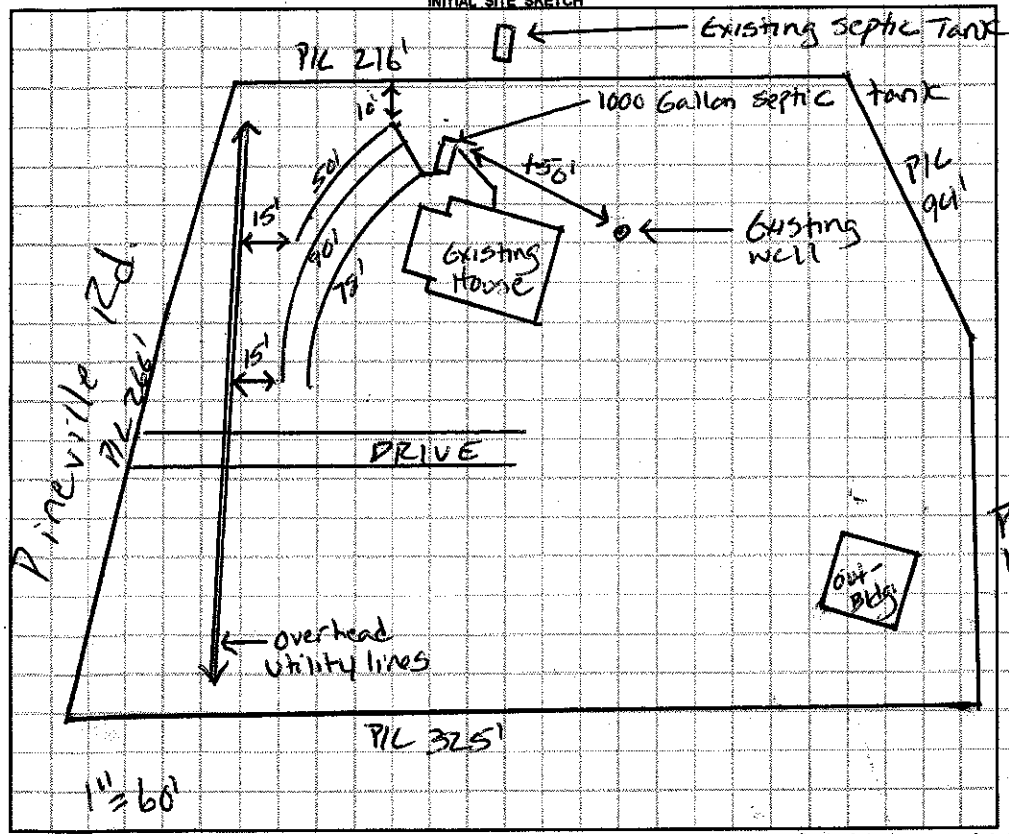

AS BUILT SKETCH

(Pump & crush)

Installed Quick 4 as drawn

Installed during rainfall

Installed Quick 4

Permit can be suspended or revoked if any false information is supplied toward securing the permit / any unauthorized changes are made to the site / any unauthorized changes are made in the installation of the system. **CONTACT A LOCATOR SERVICE PRIOR TO ANY EXCAVATION**

☐ **IMPROVEMENT PERMIT** *with plot valid without expiration.* ☑ **IMPROVEMENT PERMIT** *with site plan valid for 60 mos.* ☑ **AUTHORIZATION TO CONSTRUCT** *valid for period equal to IMPROVEMENT PERMIT--not to exceed 60 mo.*

Owner / Applicant Signature: Lisa Holzworth Date: 4-27-16 Installed by: Steve Jordan

IMPROVEMENT PERMIT by: Justin Henderson Date: 4-27-16 OPERATION PERMIT by: [signature] Date: 05/19/16

AUTHORIZATION TO CONSTRUCT by: Justin Henderson Date: 4-27-16 Existing System Inspected by: Date:

Health Dept. Copy - WHITE Applicant (Final Approval) - YELLOW Applicant (Conditional Approval) - PINK