IREDELL COUNTY HEALTH DEPARTMENT

STATESVILLE 704-878-5305 MOORESVILLE 704-664-5281

IMPROVEMENT PERMIT / CERTIFICATE OF COMPLETION / OPERATION PERMIT / EXISTING SYSTEM INSPECTION

PROPERTY DESCRIPTION NO. 69620 DATE 10-1-97 TAX MAP NO. 4711671123 Watershed: ☑ Yes ☐ No

OWNER OR CONTRACTOR Betty Ball PHONE: Business _____ Home 872 2527 Mobile PA

ADDRESS 111 Pineville Rd

LOCATION Bubbaco Shoals Rd To Pineville Rd 20: Rt

SUBDIVISION Balls Little village BLOCK / SECTION _____ LOT 4 LOT AREA .53 acres SITE CLASS. PS DESIGN FLOW 240 L.T.A.R. .13

Septic Tank: 1000 Gallons; STB 796 Date 8-29-97

Pump Tank: _____ Gallons; PT _____ Date _____

Pump Make: _____ Model _____ Serial No. _____

Nitrification Field: No Fields 1 Square Feet 800 Linear Feet 262

No Lines 4 Trench Width 36" Max Trench Bottom Depth 36" Gravel Depth 12"

☑ New System ☐ Repair System Type: I II III, IV, V, VI

System Description: Conv. Gravity

Repair System Description: Gravity Chambers

Maintenance Agreement Required: ☐ Yes ☑ No

☐ House/Mod. Home No. Bedrooms 2

☑ Mobile Home No. Bathrooms 2

☐ Business No. Employees ____

☐ Other _____


☐ Slab ☑ Crawl Space ☐ Basement w/plumbing ☐ Basement wo/plumbing

Water Supply: ☑ Individual ☐ Community ☐ Public

Comments:

Lockhart Farm

INITIAL SITE SKETCH

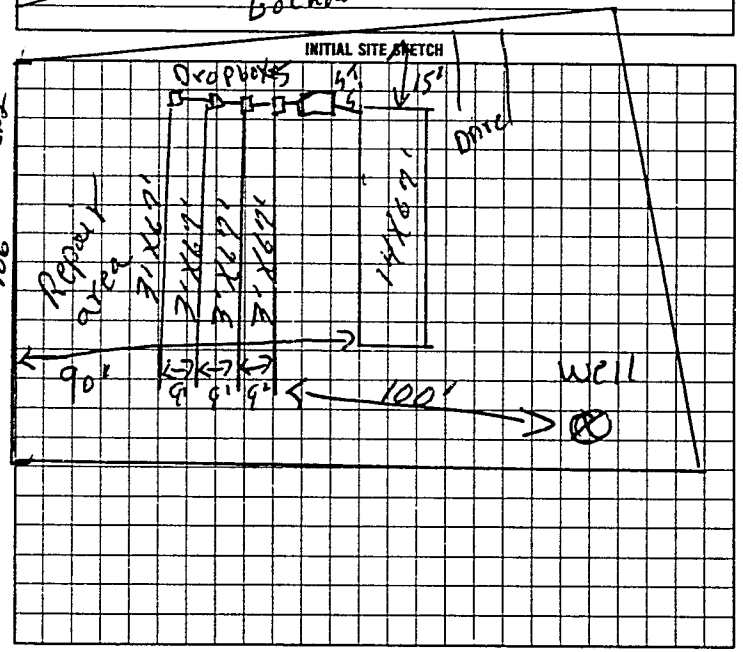

Comments:

AS BUILT SKETCH

Installed as Shown

I understand that this permit can be suspended or revoked if any false information is supplied toward securing the permit/any unauthorized changes are made to the site/any unauthorized changes are made in the installation of the system. Improvement Permit is valid for 60 months from date of issuance.

Signed: X [signature]

Improvement Permit by: L.C. Moore date 10-1-97

Authorization to Existing System Inspection by: L.C. Moore date 10-1-97

Installed by: Charlie Brice

Certificate of Completion by: _____ date _____

Operation Permit by: Mark C. Oates RS date 10-14-97

HEALTH DEPT COPY WHITE INSPECTION COPY (FINAL) GREEN OWNER COPY (FINAL) YELLOW INSPECTION COPY (INITIAL) PINK OWNER COPY (INITIAL) GOLD

to count Authorization to count Expires 60 mos from issue

S20E00