IREDELL COUNTY HEALTH DEPARTMENT

STATESVILLE 704-878-5305 MOORESVILLE 704-664-5281 ad

IMPROVEMENT PERMIT / AUTHORIZATION TO CONSTRUCT / OPERATION PERMIT / EXISTING SYSTEM INSPECTION

PERMIT# 153686 PIN# 4711 67 4793 DATE 12-2-08

OWNER OR APPLICANT Heritage Building Company PHONE: Business 704-902-4680 Home

ADDRESS 120 Hickory Point Court Statesville NC 28677

LOCATION BUFFALO SHOALS SOUTH WEST ON LEFT BY Pinevue Rd. MT BOX # 2237

SUBDIVISION BLOCK / SECTION LOT LOT AREA 1.157 SITE CLASS. DESIGN FLOW L.T.A.R.

Septic Tank: EXISTING Gallons: STB Date

Pump Tank: Gallons: PT Date

Pump Make: Model Serial No.

Nitrification Field: No Fields Square Feet Linear Feet ≈360'

No Lines 4x90? Trench Width Max Trench Bottom Depth Gravel Depth

☐ New System ☐ Repair ☐ Expansion System Type: I (II) III IV V VI

System Description: GRAVITY Conventional

Repair System Description:

Maintenance Agreement Required: ☐ Yes ☒ No

☒ House/Mod. Home ☐ Mobile Home ☐ Business ☐ Other

No. Bedrooms 3 No. Persons No. Employees

Water Supply: ☒ Individual ☐ Public ☐ Community

☒ Gravity ☐ Pressure ☒ Slab ☐ Crawl Space ☐ Basement w/plumbing ☐ Basement wo/plumbing

Comments/Conditions: (1) This is an existing system check. NO OLD RECORDS WERE FOUND (2) FROM TO NDT CHANGING & Addition will not affect initial system. (3) System is properly functioning at

INITIAL SITE SKETCH

SEE ATTACHED EXISTING SYSTEM CHECK DESIGN BY LONNIE COOK, R.S.

Comments/Conditions: time of check.

AS BUILT SKETCH

Permit can be suspended or revoked if any false information is supplied toward securing the permit/any unauthorized changes are made to the site/any unauthorized changes are made in the installation of the system. Improvement Permit with plat valid without expiration ☐ Improvement Permit with site plan valid for sixty months ☐ Authorization to Construct is valid for a period equal to that of Improvement Permit – not to exceed sixty months.

Signed: date 12-3-08

Improvement Permit by: date

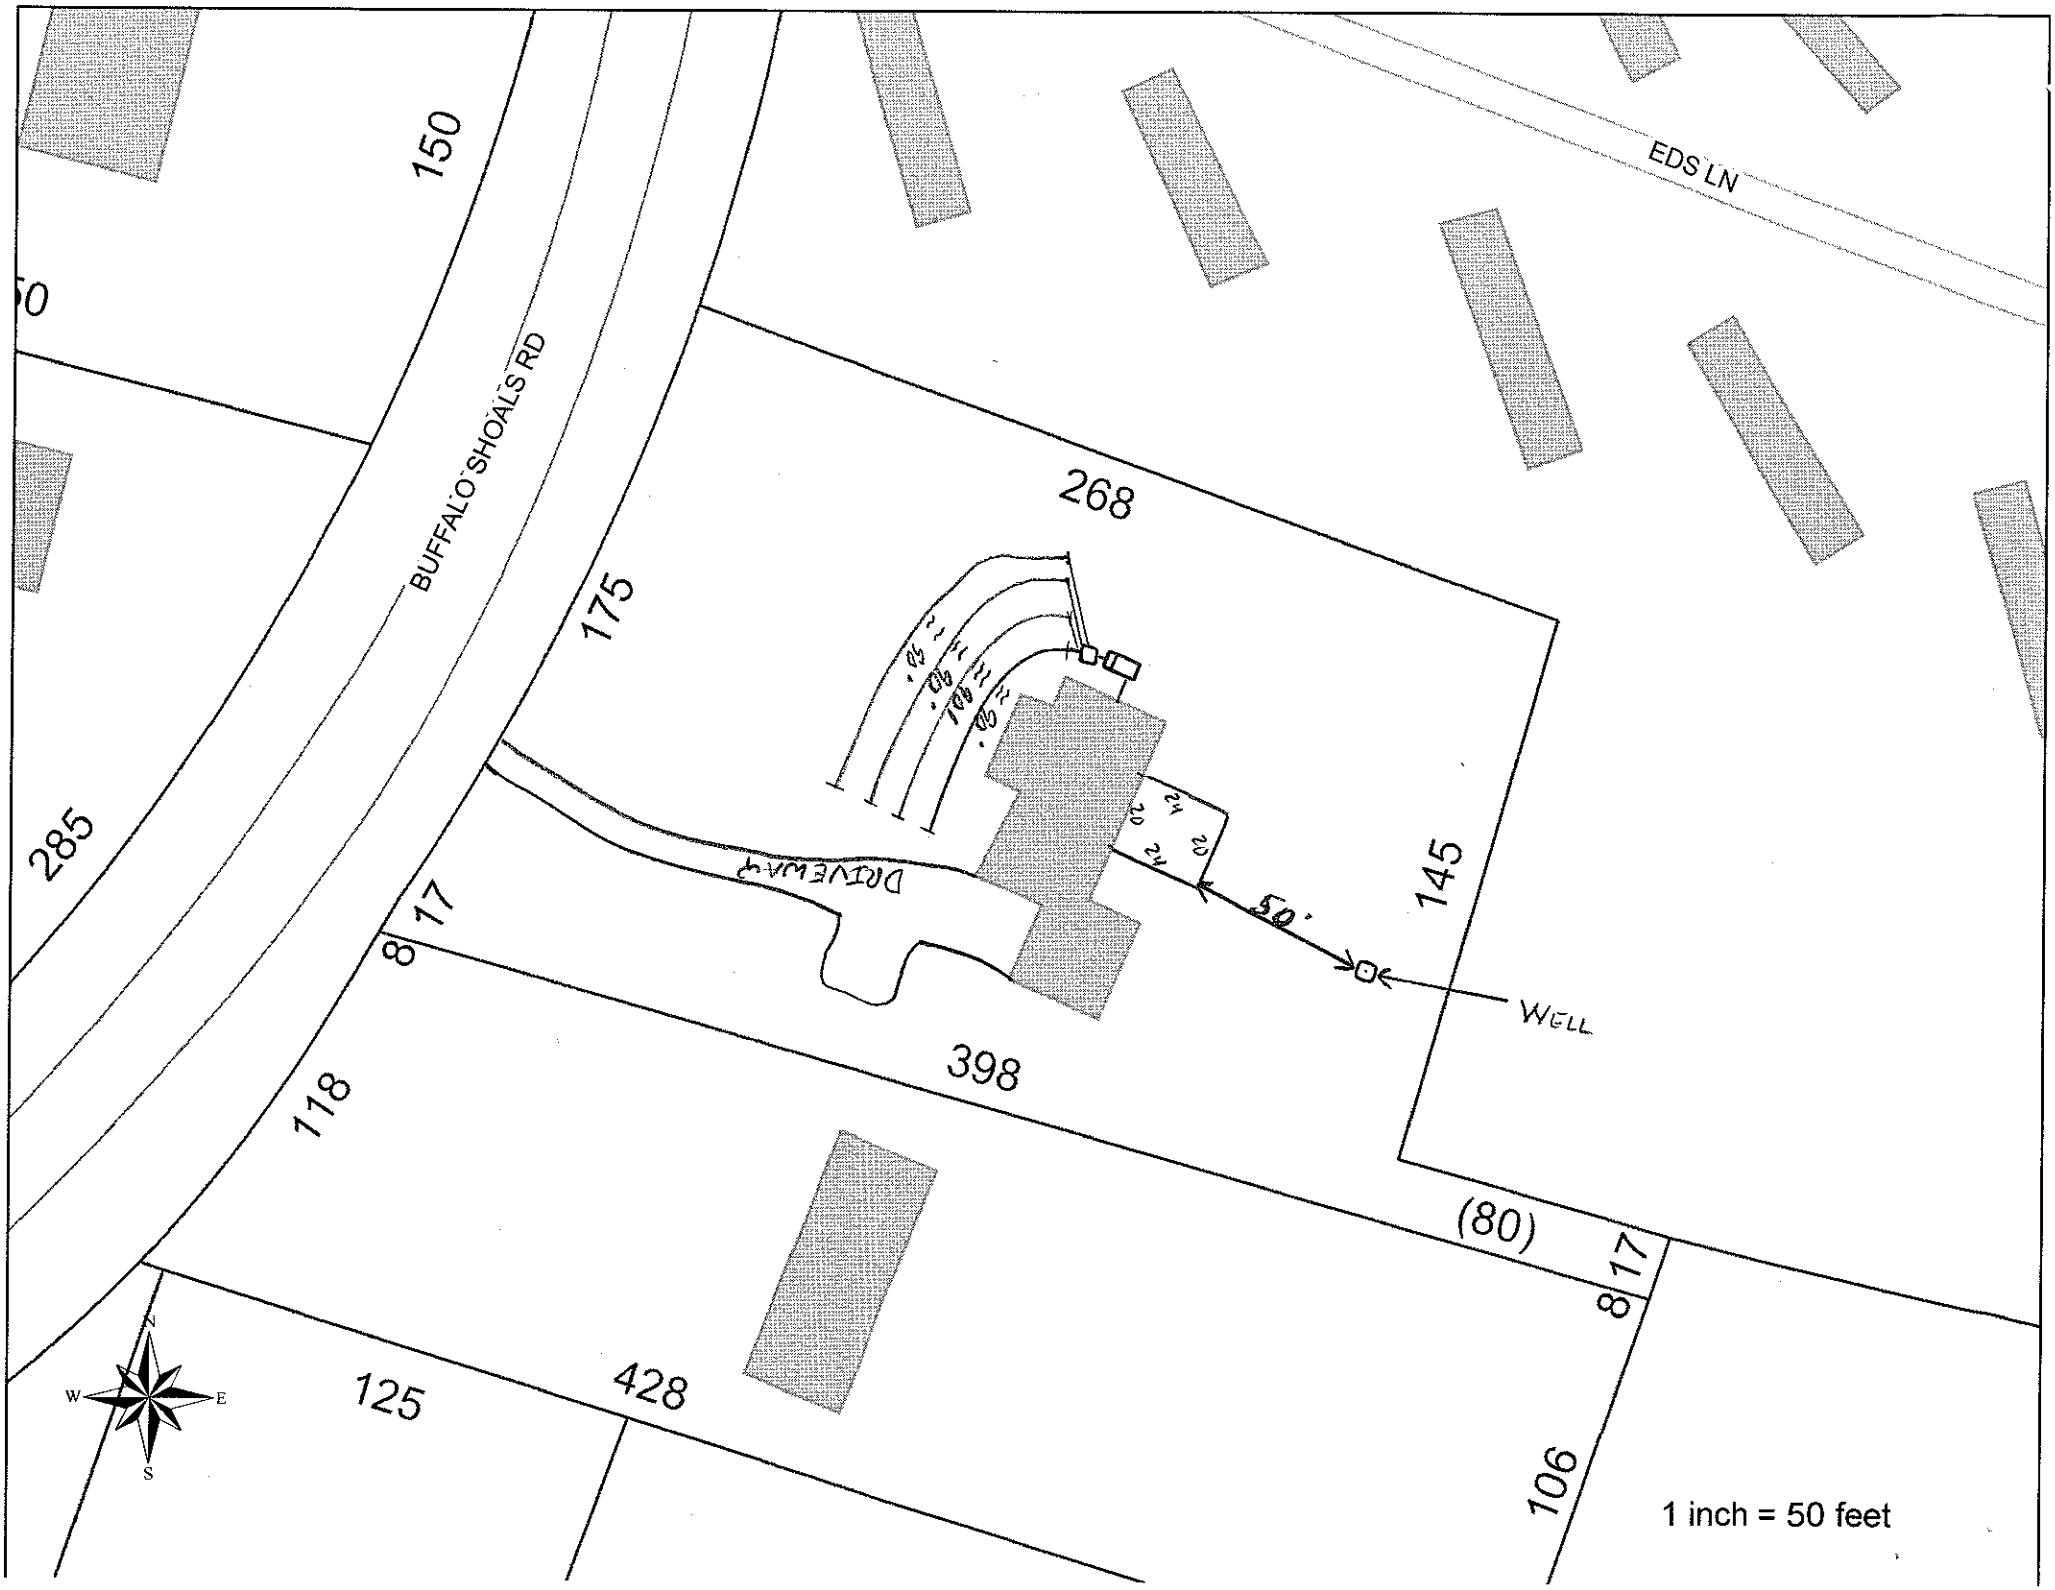
Authorization to Construct by: date

Installed by:

Operation Permit by: date

Existing System Inspection by: RS date 12-2-08

HEALTH DEPT. COPY: WHITE OWNER COPY (FINAL): YELLOW OWNER COPY (INITIAL): PINK


EDS LN
BUFFALO SHOALS RD
150
285
175
268
145
398
118
17
8
17
8
(80)
125
428
106
50'
WELL
DRIVEWAY
1 inch = 50 feet