IREDELL COUNTY HEALTH DEPARTMENT

STATESVILLE 704-878-5305 MOORESVILLE 704-664-5281

IMPROVEMENT PERMIT / AUTHORIZATION TO CONSTRUCT / OPERATION PERMIT / EXISTING SYSTEM INSPECTION

PERMIT# 81537 PIN# 4711663180 DATE 5-27-99

OWNER OR CONTRACTOR Chris Davidson PHONE: Business 528-6192 Home

ADDRESS Po Box 5607 Statesville

LOCATION Buffalo Shoals TL Pineville 600' on Rt

SUBDIVISION BLOCK / SECTION LOT LOT AREA 184' X200' SITE CLASS PS DESIGN FLOW 360 L.T.A.R. .3

Septic Tank: 1000 Gallons; STB 1012 Date 6-30-99
Pump Tank: Gallons; PT Date
Pump Make: Model Serial No.
Nitrification Field: No Fields 1 Square Feet 1200 Linear Feet 400
No Lines 5 Trench Width 36" Max Trench Bottom Depth 36" Gravel Depth 12"

☑ New System ☐ Repair System Type: ☐ I ☐ II ☐ III ☐ IV ☐ V ☐ VI
System Description: Conv. Gravity
Repair System Description: " "
Maintenance Agreement Required: ☐ Yes ☐ No


☑ House/Mod. Home No. Bedrooms 3
☐ Mobile Home No. Bathrooms 2
☐ Business No. Employees
☐ Other
☐ Slab ☑ Crawl Space ☐ Basement w/plumbing ☐ Basement wo/plumbing

Water Supply: ☑ Individual ☐ Public ☐ Community

Comments/Conditions:

Comments/Conditions

INITIAL SITE SKETCH

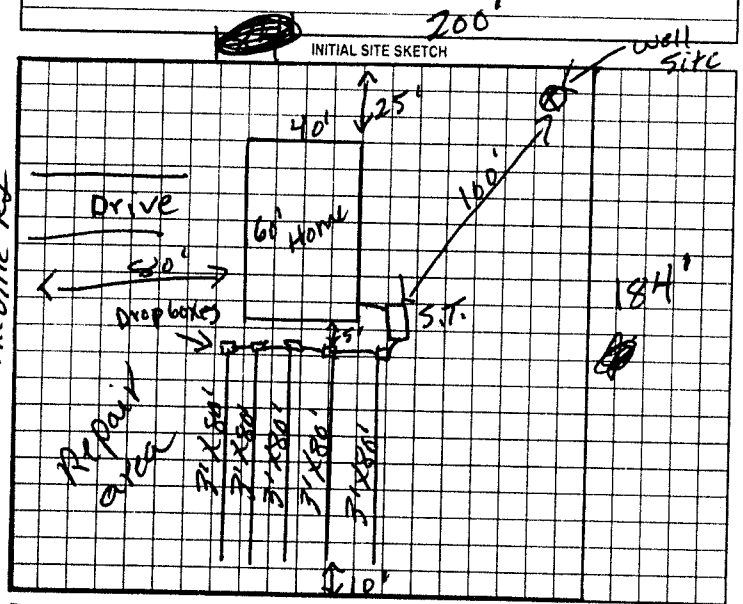

AS BUILT SKETCH

Installed as shown

Permit can be suspended or revoked if any false information is supplied toward securing the permit/any unauthorized changes are made to the site/any unauthorized changes are made in the installation of the system. Improvement Permit with plat valid without expiration. Improvement Permit with site plan valid for sixty months. Authorization to Construct is valid for a period equal to that of Improvement Permit – not to exceed sixty months.

Signed: Neil Hall date 5-28-99 Installed by: David Yountz

Improvement Permit by: E.C. Moore date 5-27-99 Operation Permit by: [illegible] date 9-1-99

Authorization to Construct by: E.C. Moore date 5-25-99 Existing System Inspection by: date

HEALTH DEPT. COPY WHITE OWNER COPY (FINAL) YELLOW OWNER COPY (INITIAL) PINK