IREDELL COUNTY HEALTH DEPARTMENT

STATESVILLE 704-878-5305 MOORESVILLE 704-664-5281

IMPROVEMENT PERMIT / AUTHORIZATION TO CONSTRUCT / OPERATION PERMIT / EXISTING SYSTEM INSPECTION

PERMIT# 81537 PIN# 4711663180

OWNER OR CONTRACTOR Chris Davidson PHONE: Business 528-6192 Home DATE 5-27-99

ADDRESS

LOCATION Buffalo Shoals PO Box 5603 TL Pineville 600' on Rt Statesville

SUBDIVISION BLOCK / SECTION LOT LOT AREA 184' X200' SITE CLASS PS DESIGN FLOW 360 L.T.A.R. .3

Septic Tank: 1000 Gallons; STB 1012 Date 6-30-99
Pump Tank: Gallons; PT Date
Pump Make: Model Serial No.
Nitrification Field: No Fields 1 Square Feet 1200 Linear Feet 400
No Lines 5 Trench Width 36" Max Trench Bottom Depth 36" Gravel Depth 12"

☑ New System ☐ Repair System Type: I (II, III, IV, V, VI)
System Description: Conv. Gravity
Repair System Description:
Maintenance Agreement Required: ☐ Yes ☐ No


☑ House/Mod. Home No. Bedrooms 3
☐ Mobile Home No. Bathrooms 2
☐ Business No. Employees
☐ Other
☐ Slab ☐ Crawl Space ☐ Basement w/plumbing ☐ Basement wo/plumbing

Water Supply: ☑ Individual ☐ Public ☐ Community

Comments/Conditions:

Comments/Conditions:

INITIAL SITE SKETCH

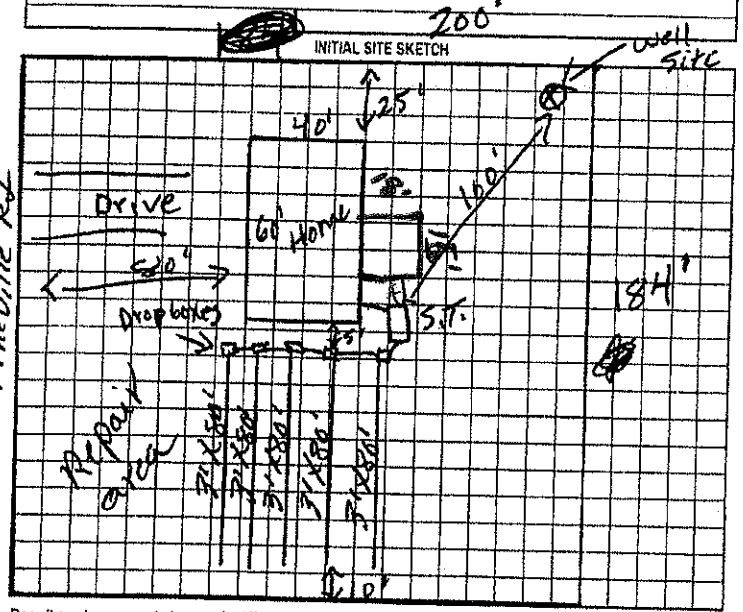

AS BUILT SKETCH

Installed as shown

Permit can be suspended or revoked if any false information is supplied toward securing the permit/any unauthorized changes are made to the site/any unauthorized changes are made in the installation of the system. Improvement Permit with plat valid without expiration. Improvement Permit with site plan valid for sixty months. Authorization to Construct is valid for a period equal to that of Improvement Permit – not to exceed sixty months.

Signed: Neil Hale date 5-28-99 Installed by: David Yontz

Improvement Permit by: P.C. Moore date 5-27-99 Operation Permit by: [illegible] date 9-1-99

Authorization to Construct by: P.C. Moore date 5-25-99 Existing System Inspection by: date

HEALTH DEPT. COPY WHITE OWNER COPY (FINAL) YELLOW OWNER COPY (INITIAL) PINK

Location of the proposed ROOM - OFFICE **addition does not appear to impact the existing on-site septic system.**NOTE:** KEEP MIN. 5' FROM TANK

R. STEVE HEDRICK REHS

Date: NOV. 2, 2012

ICHD-Environmental Health Division