IREDELL COUNTY HEALTH DEPARTMENT

STATESVILLE 704-878-5305 MOORESVILLE 704-664-5281

IMPROVEMENT PERMIT / AUTHORIZATION TO CONSTRUCT / OPERATION PERMIT / EXISTING SYSTEM INSPECTION

PERMIT# 143263 PIN# 4711-69-7680 (05 DATE 6-9-07

OWNER OR APPLICANT BRANDON WOOTEN PHONE: Business 704-902-7954 Home

ADDRESS 511 1ST STREET EAST, CONOVER NC 28613

LOCATION I-40 WEST, TL OLD MTN. RD, TR BUFFALO SHOALS RD, 2.1 MILES ON LEFT AT #2151

SUBDIVISION BLOCK / SECTION LOT LOT AREA 0.547 ACRE SITE CLASS. PS DESIGN FLOW 360 L.T.A.R. 0.30 GPD/FT²

NEW Septic Tank EXISTING Gallons: STB 786 Date 4-10-07

Pump Tank: 1000 Gallons: PT Date

Pump Make: Model EQUITY Serial No.

Nitrification Field: No. Fields 1 Square Feet 1200 Linear Feet 300

No. Lines ~~THREE~~ FOUR French Width 36" Max Trench Bottom Depth 36" Gravel Depth N/A

☑ New System ☐ Repair ☐ Expansion System Type: I II III IV V VI

System Description: 25% REDUCTION, GENIM

Repair System Description: 25% REDUCTION, GENIM

Maintenance Agreement Required: ☐ Yes ☑ No

☐ House/Mod. Home ☑ Mobile Home ☑ Business ☐ Other

No. Bedrooms 3 No. Persons No. Employees


Water Supply: ☑ Individual ☐ Public ☐ Community WELL

☑ Gravity ☐ Pressure ☐ Slab ☐ Crawl Space ☐ Basement w/plumbing ☐ Basement wo/plumbing

Comments/Conditions: ① EXPAND SYSTM BY ABANDONING EXISTING LINES & INSTALLING NEW 25% REDUCTION SYSTEM ON CONTOUR.

Comments/Conditions: AUTH. TO CONSTRUCT TO BE ISSUED UPON RECORDING WITH REGISTER of DEEDS ADDITIONAL PROPERTY AS SHOWN,

INITIAL SITE SKETCH ~ SCALE: 1" = 40' AS BUILT SKETCH

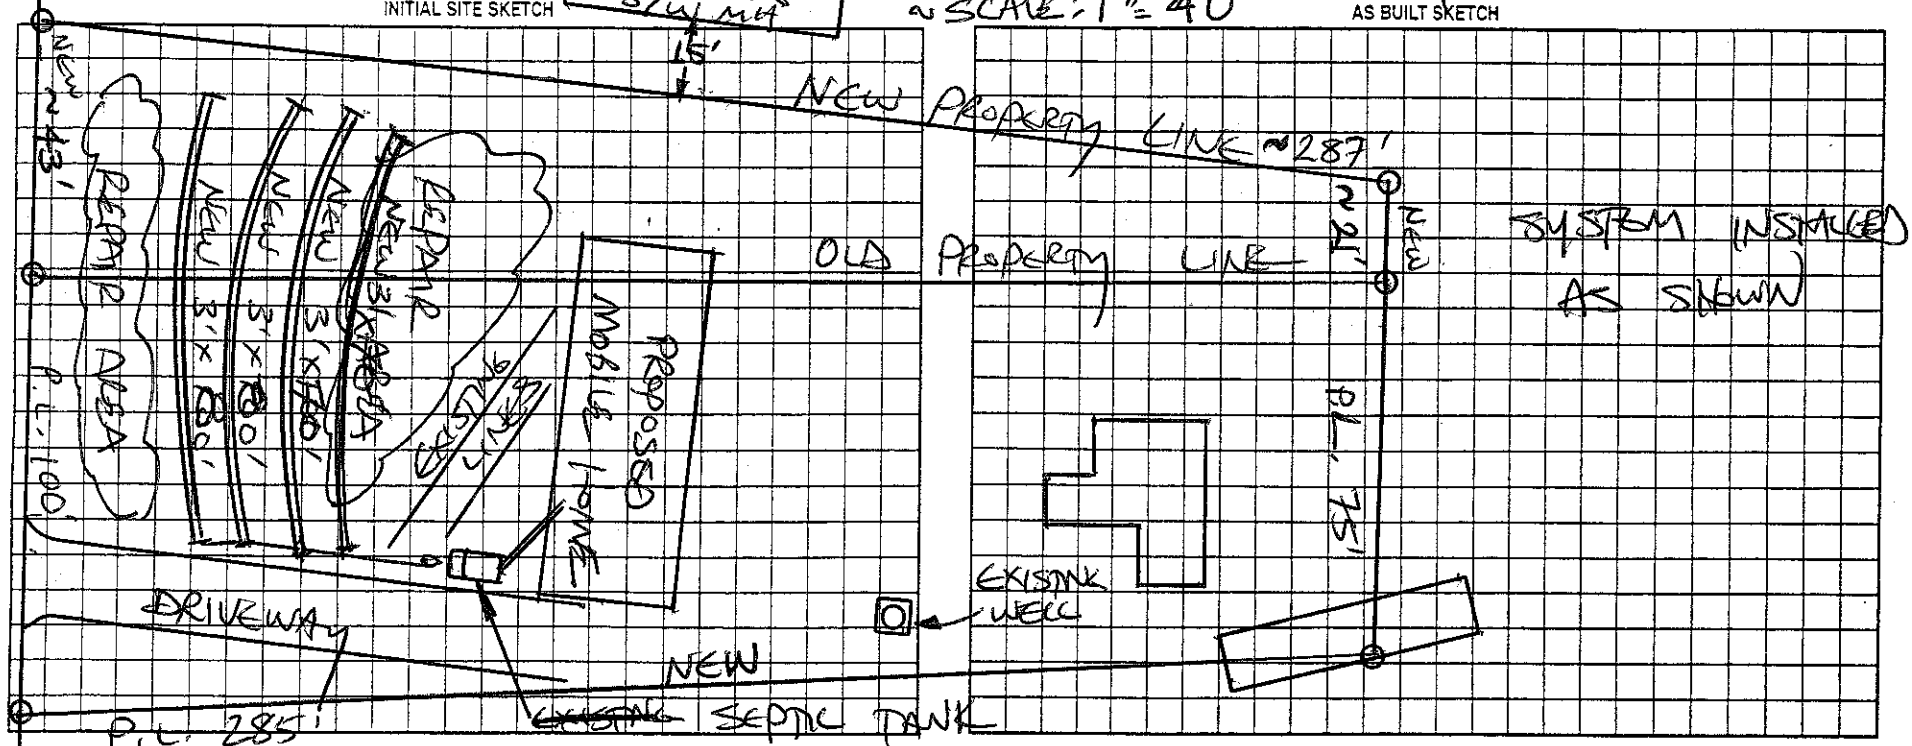

Permit can be suspended or revoked if any false information is supplied toward securing the permit/any unauthorized changes are made to the site/any unauthorized changes are made in the installation of the system. Improvement Permit with plat valid without expiration ☐ Improvement Permit with site plan valid for sixty months ☐ Authorization to Construct is valid for a period equal to that of Improvement Permit – not to exceed sixty months.

Signed: Amy M Britton date 6/9/07 Installed by: ROGER PROST

Improvement Permit by: STEVE HEDRICK date 6/9-07 Operation Permit by: STEVE HEDRICK date 7-13-07

Authorization to Construct by: STEVE HEDRICK date 6-29-07 Existing System Inspection by: date

HEALTH DEPT. COPY: WHITE OWNER COPY (FINAL): YELLOW OWNER COPY (INITIAL): PINK