IREDELL COUNTY HEALTH DEPARTMENT

STATESVILLE 704-878-5305 MOORESVILLE 704-664-5281 CI

IMPROVEMENT PERMIT / AUTHORIZATION TO CONSTRUCT / OPERATION PERMIT / EXISTING SYSTEM INSPECTION

PERMIT# 11621 2 PIN# 4711-69-2650 7665 DATE 10/15/03

OWNER OR CONTRACTOR Roberta Wike PHONE: Business — Home (704) 528-4197

ADDRESS 2145 Buffalo Shoals Rd, Statesville, N.C. 28677

LOCATION Buffalo Shoals Road, Cross old mtn Rd. 3 miles on Left @ 2151 Buffalo Shoals Rd

SUBDIVISION — BLOCK / SECTION — LOT — LOT AREA 1.79 Acres SITE CLASS. _____ DESIGN FLOW 360 L.T.A.R. Ex

Septic Tank: Ex 1,000 Gallons; STB _____ Date _____

Pump Tank: _____ Gallons; PT _____ Date _____

Pump Make: _____ Model _____ Serial No. _____

Nitrification Field: No Fields 1 Square Feet Ex Linear Feet ~240 FT

No Lines 2 @ 120 Trench Width Ex Max Trench Bottom Depth Ex Gravel Depth Ex

☐ New System ☐ Repair System Type: I, (II), III, IV, V, VI

System Description: Existing Conventional, Gravity

Repair System Description: _____

Maintenance Agreement Required: ☐ Yes ☐ No

☐ House/Mod. Home No. Bedrooms 3

☒ Mobile Home No. Bathrooms 2

☐ Business No. Employees ____

☐ Other _____

☐ Slab ☒ Crawl Space ☐ Basement w/plumbing ☐ Basement wo/plumbing

Water Supply: ☒ Individual ☐ Public ☐ Community


Comments:/Conditions:

INITIAL SITE SKETCH

Comments:/Conditions:

284.06 New PL

AS BUILT SKETCH

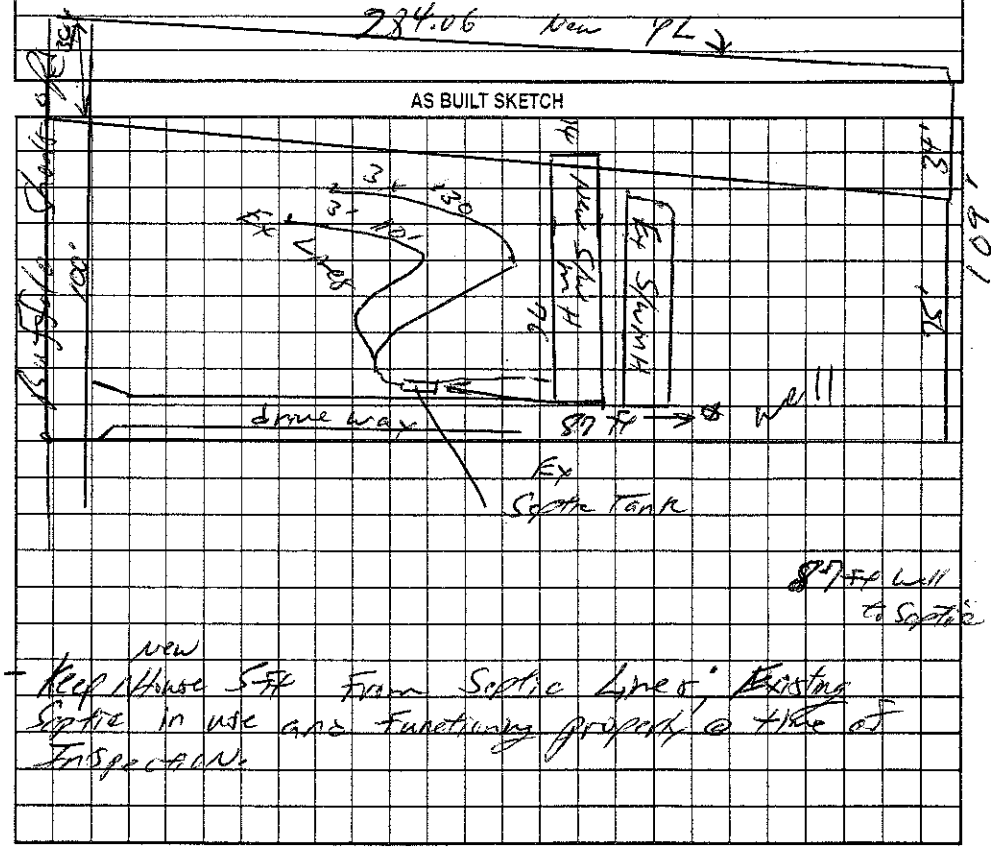

Permit can be suspended or revoked if any false information is supplied toward securing the permit/any unauthorized changes are made to the site/any unauthorized changes are made in the installation of the system. Improvement Permit with plat valid without expiration. Improvement Permit with site plan valid for sixty months. Authorization to Construct is valid for a period equal to that of Improvement Permit – not to exceed sixty months.

Signed: _____ date _____ Installed by: _____

Improvement Permit by: _____ date _____ Operation Permit by: _____ date _____

Authorization to Construct by: _____ date _____ Existing System Inspection by: William O. Johnson date 10/15/03

HEALTH DEPT. COPY: WHITE OWNER COPY (FINAL): YELLOW OWNER COPY (INITIAL): PINK