IREDELL COUNTY HEALTH DEPARTMENT

STATESVILLE 704-878-5305 CI MOORESVILLE 704-664-5281

IMPROVEMENT PERMIT / AUTHORIZATION TO CONSTRUCT / OPERATION PERMIT / EXISTING SYSTEM INSPECTION

PERMIT# 111949 PIN# 4711-76-1786 DATE 07/23/03

OWNER OR CONTRACTOR WINDY VIRTUE PHONE: Business 704-662-3351 Home 704-883-0483

ADDRESS 170 PINEVILLE RD, STATESVILLE, NC 28677 704-929-6244 704-924-9119

LOCATION BUFFALO SHOALS RD, (L) PINEVILLE RD, ~0.3 MILES (R) HUSKY LN, 2ND ON RIGHT.

SUBDIVISION LARRY LIPPARD BLOCK / SECTION ____ LOT X (1) LOT AREA 0.50 ACRES SITE CLASS. PS DESIGN FLOW 240 GPD L.T.A.R. 0.30 GPD/FT2

Septic Tank: 1,060 Gallons; STB 620 Date 9-7-02

Pump Tank: ____ Gallons; PT ____ Date ____

Pump Make: ____ Model ____ Serial No. ____

Nitrification Field: No Fields 1 Square Feet EQ to 800 Linear Feet 140

No Lines 4@35' Trench Width 24" Max Trench Bottom Depth 36" Gravel Depth N/A

X New System ☐ Repair System Type: I, II, (III), IV, V, VI

System Description: 50% REDUCTION, GRAVITY

Repair System Description: 50% REDUCTION, GRAV/PUMP

Maintenance Agreement Required: ☐ Yes X No

☐ House/Mod. Home No. Bedrooms 2

X Mobile Home No. Bathrooms 2

☐ Business No. Employees ____

☐ Other ____

☐ Slab X Crawl Space ☐ Basement w/plumbing ☐ Basement wo/plumbing


Water Supply: X Individual ☐ Public ☐ Community EXISTING WELL

Comments/Conditions: (1) INSTALL SYSTEM USING 8 PANELS PER LINE (32 PANELS TOTAL TO EQUAL 140'), (2) USE 1 FLOW DIVIDER "T" + 2 DISTRIBUTION BOXES W/ SPEED LEVELERS TO ACHIEVE EQUAL DISTRIBUTION, (3) SYSTEM


Comments/Conditions: → MUST BE 100' PLUS FROM WELLS. (4) HOME MUST FACE FRONT PROPERTY LINE, NO MORE THAN 20° ANGLE, AS SHOWN.

– Zabel filter FST

INITIAL SITE SKETCH

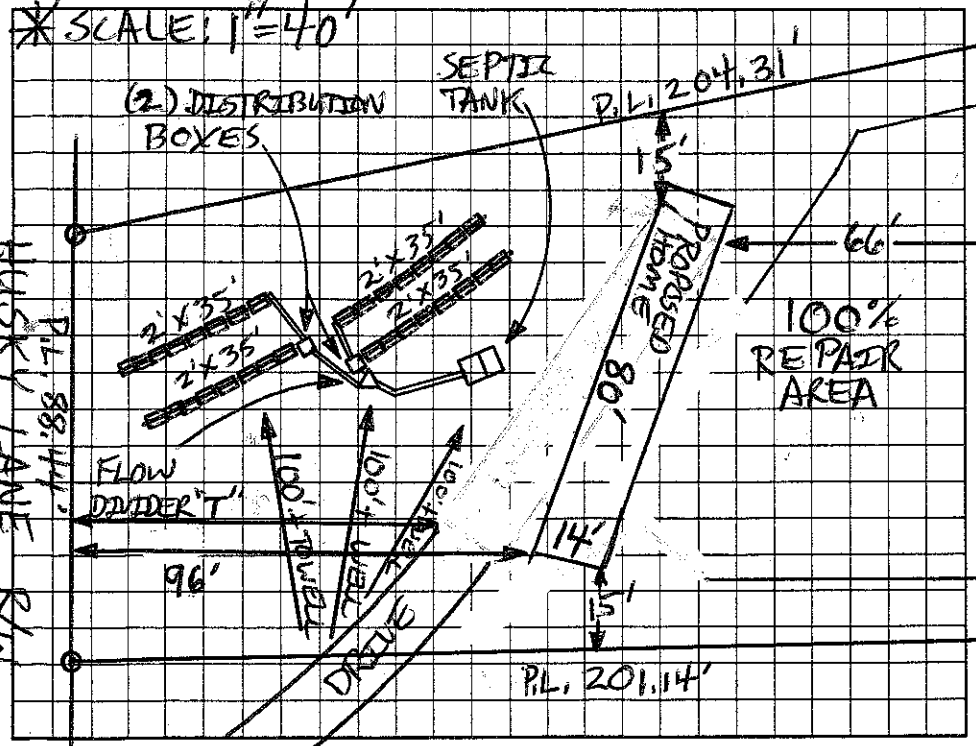

AS BUILT SKETCH

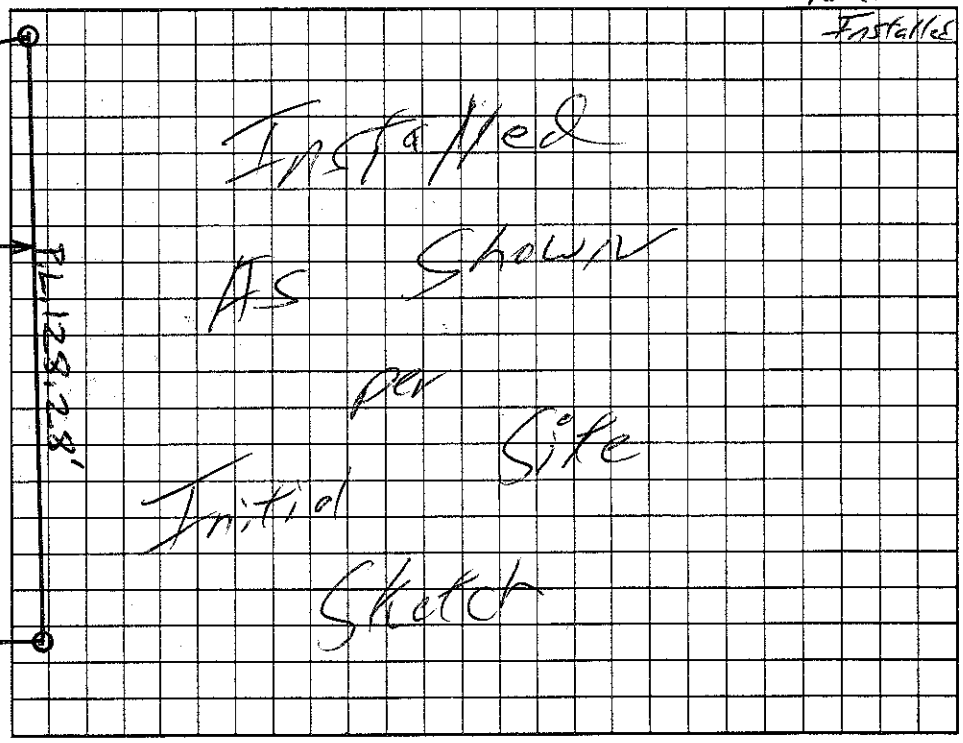

Permit can be suspended or revoked if any false information is supplied toward securing the permit/any unauthorized changes are made to the site/any unauthorized changes are made in the installation of the system. Improvement Permit with plat valid without expiration. Improvement Permit with site plan valid for sixty months. Authorization to Construct is valid for a period equal to that of Improvement Permit – not to exceed sixty months.

Signed: Windy Virtue date 7/23/03 Installed by: Sammy Reavis

Improvement Permit by: Patrick Mitchell date 07/23/03 Operation Permit by: William A. Johnson date 8/20/03

Authorization to Construct by: Patrick Mitchell date 07/23/03 Existing System Inspection by: ____ date ____

HEALTH DEPT. COPY: WHITE OWNER COPY (FINAL): YELLOW OWNER COPY (INITIAL): PINK