IREDELL COUNTY HEALTH DEPARTMENT

Statesville Phone TR 3-7271 Mooresville Phone No. 664-5281

PERMIT TO INSTALL SEPTIC TANK

Permit No. 11 Permit Date 6-25 1973

Owner The Pines Trailer Pk. ED. West Address Statesville NC

Installed By Henry Sigmon Address Statesville NC.


Location of Property Buffalo Shoals on L.
Just before E. Monbo Rd
1st Tank on L.

Tank		Capacity		Length of Lines		Fixtures	
Block	( )	1000	( )	225'	( )	No. of Baths	( )
Precast	( )	1250	( )	250'	( )	Dishwasher	( )
		1500	( )	Other 150'		Garbage Grdr.	( )
		Other				Other	

NOTIFY HEALTH DEPARTMENT AT LEAST EIGHT HOURS BEFORE TANK IS TO BE INSPECTED.

Final Inspection 6-25 1973 Approved (✓) Disapproved ( )

Remarks

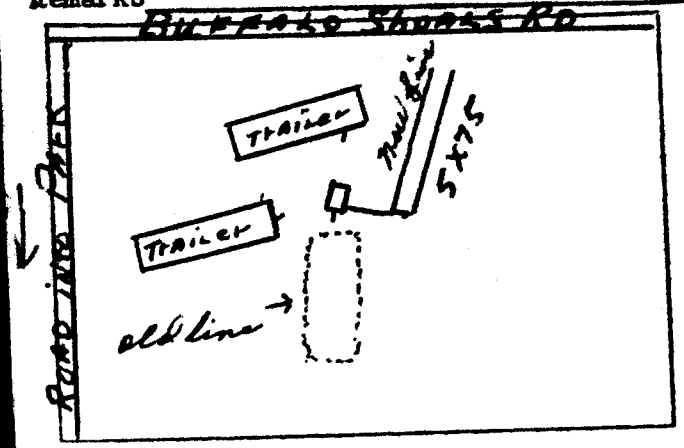

Sketch of Installation

Repair
T- Put in side outlet
For Repair Line

E. G. Stevenson
Sanitarian