IREDELL COUNTY HEALTH DEPARTMENT

STATESVILLE 704-878-5305 MOORESVILLE 704-664-5281

IMPROVEMENT PERMIT / AUTHORIZATION TO CONSTRUCT / OPERATION PERMIT / EXISTING SYSTEM INSPECTION

PERMIT# Repair PIN# DATE 5-11-99

OWNER OR CONTRACTOR Judy Voelskie PHONE: Business Home

ADDRESS 550 Pineville Rd Statesville

LOCATION Buffalo Shoals Rd TL Pineville Rd house on (R)

SUBDIVISION BLOCK / SECTION LOT LOT AREA SITE CLASS P/S DESIGN FLOW 360 L.T.A.R.

Septic Tank: 1000 Ex Gallons: STB Date

Pump Tank: Gallons: PT Date

Pump Make: Model Serial No

Nitrification Field: No Fields 1 Square Feet 600 Linear Feet 200±

No Lines 2 Trench Width 36 Max Trench Bottom Depth 36

☐ New System ☒ Repair System Type: (II) III, IV, V, VI

System Description:

Repair System Description: Gravity Conventional

Maintenance Agreement Required: ☐ Yes ☒ No

Gravel Depth 18in

☒ House/Mod. Home No. Bedrooms 3

☐ Mobile Home No. Bathrooms 2

☐ Business No. Employees

☐ Other


Slab ☒ Crawl Space ☐ Basement w/plumbing ☐ Basement wo/plumbing

Water Supply: ☒ Individual ☐ Public ☐ Community


Comments/Conditions: This Permit serves as 'Notice of Violation'
Install 2 lines w/ 18in stone
Check sump for 'T'
Need to smooth & landscape

Comments/Conditions:
~~# ##~~ Washer line needs to be tied into tank

INITIAL SITE SKETCH

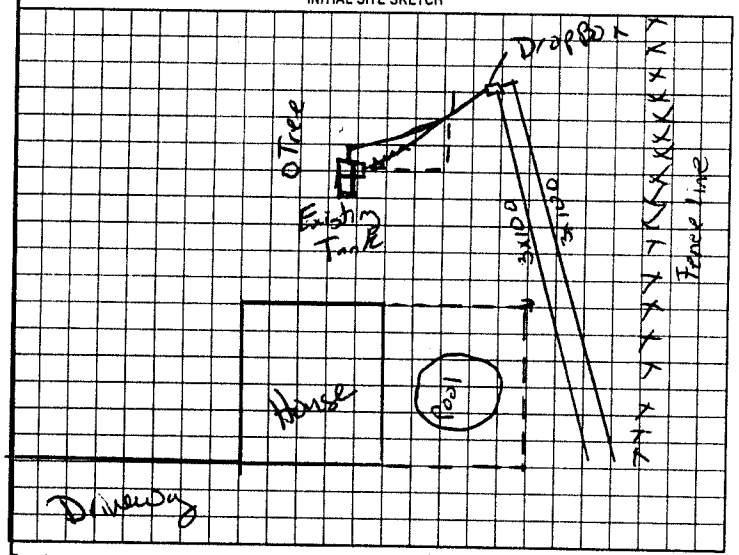

AS BUILT SKETCH

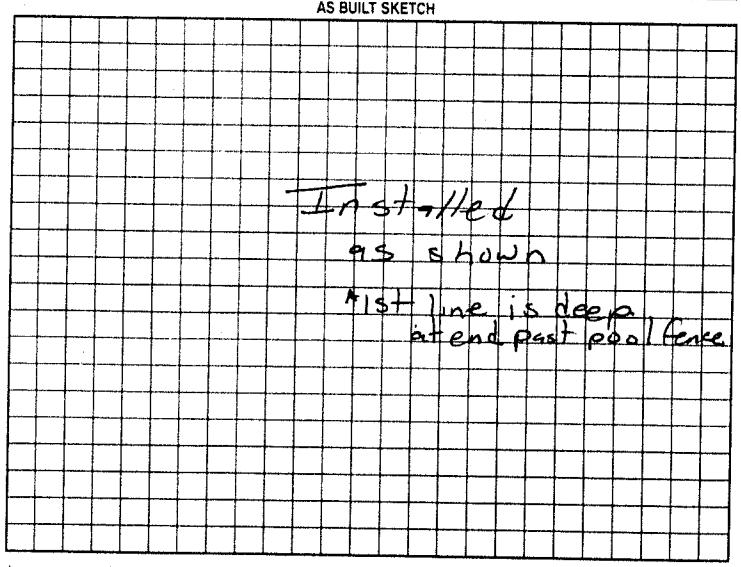

Permit can be suspended or revoked if any false information is supplied toward securing the permit/any unauthorized changes are made to the site/any unauthorized changes are made in the installation of the system. Improvement Permit with plat valid without expiration. Improvement Permit with site plan valid for sixty months. Authorization to Construct is valid for a period equal to that of Improvement Permit – not to exceed sixty months.

Signed: Mary Lynn Hege Dist date 5-11-99

Improvement Permit by: Mary C Ostrs date 5-11-99

Authorization to Construct by: Mary C Ostrs date 5-11-99

Installed by: Berry Sigmon

Operation Permit by: Mary C Ostrs date 5-19-99

Existing System Inspection by: date

HEALTH DEPT COPY WHITE OWNER COPY (FINAL) YELLOW OWNER COPY (INITIAL) PINK