IREDELL COUNTY HEALTH DEPARTMENT

STATESVILLE 704-878-5305 MOORESVILLE 704-664-5281

2230

IMPROVEMENT PERMIT / CERTIFICATE OF COMPLETION / OPERATION PERMIT / EXISTING SYSTEM INSPECTION

PROPERTY DESCRIPTION NO. 26707 DATE June 9, 97 TAX MAP NO. 4711983982 Watershed: ☐ Yes ☑ No

OWNER OR CONTRACTOR Janice Eades PHONE: Business _____ Home _____

ADDRESS 143 Amber Lane Statesville

LOCATION Buffalo Shoals Rd. to Eufola, TR Amber Lane AT END

SUBDIVISION Eades Hollow BLOCK / SECTION _____ LOT 2 LOT AREA ~20,000sqft SITE CLASS. B5 DESIGN FLOW 240gpd L.T.A.R. .3

Septic Tank: 1000 Gallons; STB 1012 Date 5-30-97

Pump Tank: _____ Gallons; PT _____ Date _____

Pump Make: _____ Model _____ Serial No. _____

Nitrification Field: No Fields 1 Square Feet 800 Linear Feet 267

No Lines 4@66' Trench Width 36" Max Trench Bottom Depth 36"

☑ New System ☐ Repair System Type: I, II, III, IV, V, VI

System Description: gravity conventional

Repair System Description: pump chmb. / chamber

Maintenance Agreement Required: ☐ Yes ☑ No

Gravel Depth 12" ☐ Slab ☑ Crawl Space ☐ Basement w/plumbing ☐ Basement wo/plumbing

☐ House/Mod. Home No. Bedrooms 2

☑ Mobile Home No. Bathrooms 1

☐ Business No. Employees _____

☐ Other _____


Water Supply: ☑ Individual ☐ Community ☐ Public

Comments:

Comments:

1"=60'

INITIAL SITE SKETCH

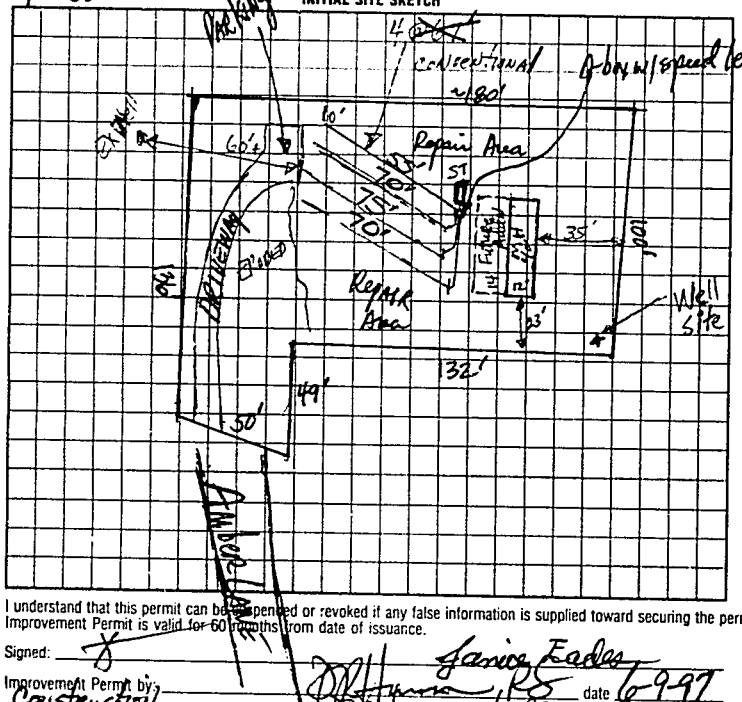

AS BUILT SKETCH

SYSTEM INSTALLED AS SHOWN

I understand that this permit can be suspended or revoked if any false information is supplied toward securing the permit/any unauthorized changes are made to the site/any unauthorized changes are made in the installation of the system. Improvement Permit is valid for 60 months from date of issuance.

Signed: X

Improvement Permit by: Construction Authorization Janice Eades date 6-9-97

Existing System Inspection by: _____ date _____

Installed by: DONALD LACKEY

Certificate of Completion by: _____ date _____

Operation Permit by STEVE HEDRICK date 8-7-97

APPLICANT COPY WHITE INSPECTION COPY (FINAL) GREEN OWNER COPY (FINAL) YELLOW INSPECTION COPY (INITIAL) PINK OWNER COPY (INITIAL) GOLD

9617000