IREDELL COUNTY HEALTH DEPARTMENT

Statesville Office (704) 878-5305 Mooresville Office (704) 660-3625

PERMIT # 218751

IMPROVEMENT PERMIT / AUTHORIZATION TO CONSTRUCT / OPERATION PERMIT / EXISTING SYSTEM

PIN # 4711-98-4338

APPLICANT: Daniel Ford APPLICANT ADDRESS: 7537 Chasewater Dr. Harrisburg, NC 28075

SITE ADDRESS: 113 High Springs Ct. Statesville, NC 28677 PHONE: 704-608-6376 ALT. PHONE:

SITE DIRECTIONS: Buffalo Shoals Rd W from Statesville → L on Eufola Rd → R on Amber Lane → L on Aubry Dr → R on High Springs Ct.


SUBDIVISION: Anthony Day Estates SECTION: — LOT # 8 LOT AREA: 0.959 acres DESIGN FLOW: 360 GPD L.T.A.R.: 0.30

Septic Tank	1000 (gal)	Shared Tank	1000	Date	1-9-17	☒ New System ☐ Repair ☐ Expansion	System Type: I II III IV V VI	☒ Residence	No. Bedrooms	3	Water Supply: ☒ Private (Shared) ☐ Public ☐ Community
Pump Tank	— (gal)	PT	—	Date	—	System Description:	25% Reduction	☐ Business	No. Persons	6	
Pump Make	—	Model	—	Serial #	—	Repair System Description:	50% Reduction	☐ Other	No. Employees	—	
# Nitrification Fields	1	# Lines	5	Linear Ft:	300	Maintenance Agreement Required:	☐ YES ☒ NO	☐ Slab	☒ Crawl Space		
Trench Width	36"	Max. Trench Bottom Depth	30" [low side]	Gravel Depth	—		☒ GRAVITY ☐ PRESSURE	☐ Basement w/plumbing		☐ Basement w/o plumbing	


Comments / Conditions: Follow all N.C. septic rules. Though 318 l.f. of drainfield lines were laid out, only 300 l.f. need be installed. Recommend pumping septic tank every 3-5 years.

Used Quick 4, installed essentially as drawn

INITIAL SITE SKETCH

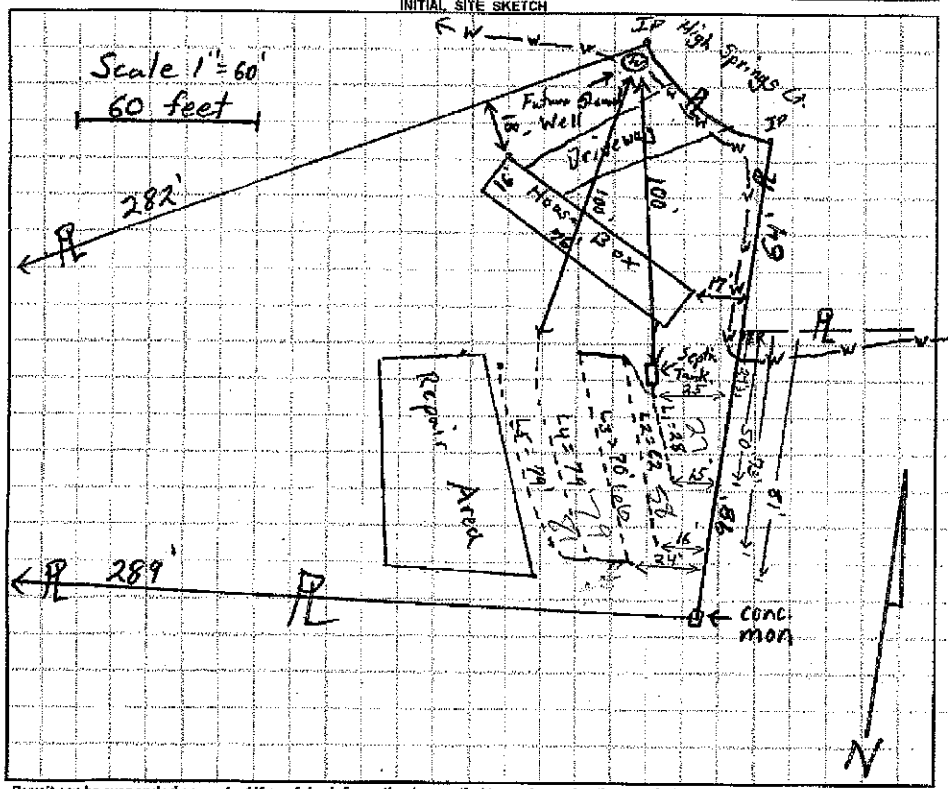

AS BUILT SKETCH

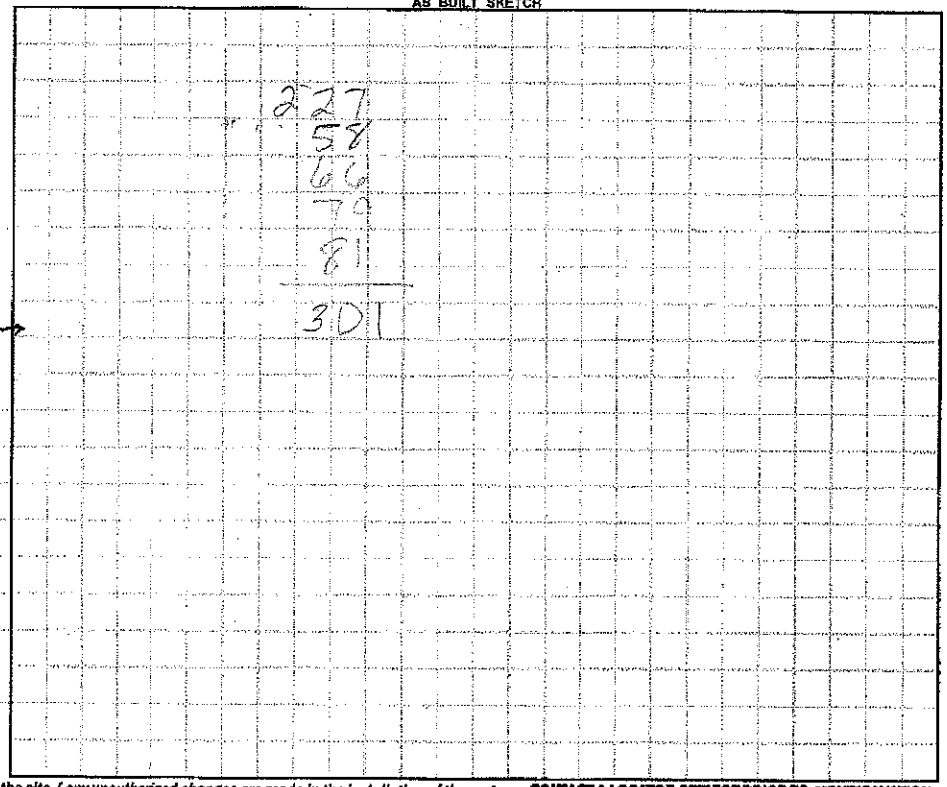

Permit can be suspended or revoked if any false information is supplied toward securing the permit / any unauthorized changes are made to the site / any unauthorized changes are made in the installation of the system. **CONTACT A LOCATOR SERVICE PRIOR TO ANY EXCAVATION**

☐ **IMPROVEMENT PERMIT** *with plat valid without expiration.* ☒ **IMPROVEMENT PERMIT** *with site plan valid for 60 mos.* ☒ **AUTHORIZATION TO CONSTRUCT** *valid for period equal to IMPROVEMENT PERMIT--not to exceed 60 mo.*

Owner / Applicant Signature: Daniel Ford Date: 10/6/16 Installed by: Dunn Grading

IMPROVEMENT PERMIT by: Tom Shuck Date: 9-30-16 OPERATION PERMIT by: Maria DeBoer Date: 2/24/17

AUTHORIZATION TO CONSTRUCT by: Tom Shuck Date: 10-6-2016 Existing System Inspected by: Date:

Health Dept. Copy - WHITE Applicant (Final Approval) - YELLOW Applicant (Conditional Approval) - PINK