IREDELL COUNTY HEALTH DEPARTMENT

STATESVILLE 704-878-5305 MOORESVILLE 704-664-5281

IMPROVEMENT PERMIT / CERTIFICATE OF COMPLETION / OPERATION PERMIT / EXISTING SYSTEM INSPECTION

CA #125 10-9-97

PROPERTY DESCRIPTION NO. 68617 DATE 10-8-97 TAX MAP NO. 4171 98 5973 Watershed: ☑ Yes ☐ No

OWNER OR CONTRACTOR Virginia Eades PHONE: Business _____ Home 528 6126 WS IV CA

ADDRESS 142 Amber Ln

LOCATION Buffalo Shoals Tl Eufola TR Amber Ln at end RT

SUBDIVISION Eades Hollow BLOCK / SECTION _____ LOT 3 LOT AREA 21780 SITE CLASS. PS DESIGN FLOW 240 L.T.A.R. .3

Septic Tank: 1000 Gallons; STB 1017 Date 7-24-97

Pump Tank: 1000 Gallons; PT 17 Date 9-4-97

Pump Make: Goulds Model WE 07112H Serial No 97137032

Nitrification Field: No Fields 1 Square Feet 600 Linear Feet 200

No Lines 3 Trench Width 36" Max Trench Bottom Depth 24" Gravel Depth N/A

☐ New System ☐ Repair System Type: I, II, ☑ IV, V, VI

System Description: Pump To Chambers

Repair System Description: " " "

Maintenance Agreement Required: ☐ Yes ☐ No

☐ House/Mod. Home No. Bedrooms 2

☐ Mobile Home No. Bathrooms 2

☐ Business No. Employees ____

☐ Other ____


☐ Slab ☐ Crawl Space ☐ Basement w/plumbing ☐ Basement wo/plumbing

Water Supply: ☑ Individual ☐ Community ☐ Public


Comments: See Attached Sheets for P.T. pressure manifold + clean out which are part of this permit

Comments:

INITIAL SITE SKETCH

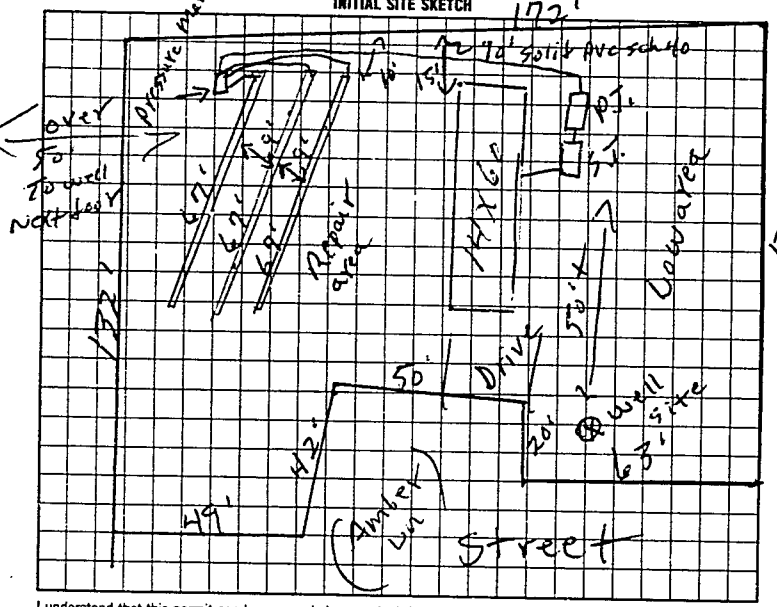

AS BUILT SKETCH

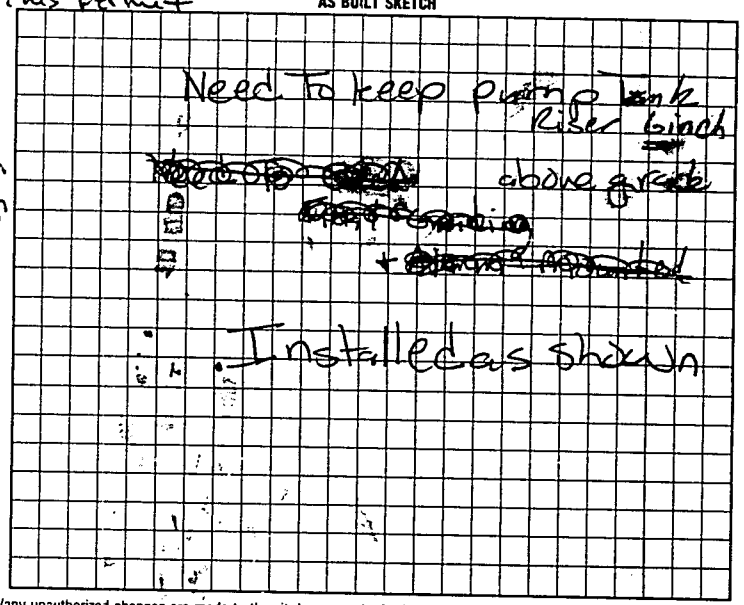

I understand that this permit can be suspended or revoked if any false information is supplied toward securing the permit/any unauthorized changes are made to the site/any unauthorized changes are made in the installation of the system. Improvement Permit is valid for 60 months from date of issuance.

Signed: Virginia Eades

Improvement Permit by: P.C. Moore date 10-8-97

Authorization to Existing System Inspection by: P.C. Moore date 10-8-97

Installed by: Donald Lackey

Certificate of Completion by: _____ date _____

Operation Permit by: Mat C Outlaw RS date 10-16-97

Authorization to count Expires 60 months from issue

HEALTH DEPT. COPY: WHITE INSPECTION COPY (FINAL): GREEN OWNER COPY (FINAL): YELLOW INSPECTION COPY (INITIAL): PINK OWNER COPY (INITIAL): GOLD

105000