CI

IREDELL COUNTY HEALTH DEPARTMENT

STATESVILLE 704-878-5305 MOORESVILLE 704-664-5281

IMPROVEMENT PERMIT / AUTHORIZATION TO CONSTRUCT / OPERATION PERMIT / EXISTING SYSTEM INSPECTION

PERMIT# 119869 PIN# 4711-98-6398 DATE 5-10-04

OWNER OR CONTRACTOR ANTHONY DAY PHONE: Business ______ Home 704-528-4832

ADDRESS 1641 EUFOLA ROAD STATESVILLE NC 28677

LOCATION BUFF SHOALS (L) EUFOLA (R) AMBER (L) ANTHONY DAY ON RT CORNER OF ANTHONY DAY & VICKY COURT

SUBDIVISION ANTHONY DAY EST BLOCK / SECTION ______ LOT 7 LOT AREA 0.503 SITE CLASS. PS DESIGN FLOW 360 L.T.A.R. .25

Septic Tank: 1060 Gallons; STB 1012 Date 2-4-04
Pump Tank: ______ Gallons; PT ______ Date ______
Pump Make: ______ Model ______ Serial No. ______
Nitrification Field: No Fields 1 Square Feet ED=1440 Linear Feet 360'
No Lines 5X72' Trench Width 36" Max Trench Bottom Depth 36" Gravel Depth N/A

[X] New System ☐ Repair System Type: I, II, (III), IV, V, VI
System Description: GRAV 25% RED
Repair System Description: LP PAVEL
Maintenance Agreement Required: ☐ Yes [X] No

☐ Slab [X] Crawl Space ☐ Basement w/plumbing ☐ Basement wo/plumbing


☐ House/Mod. Home No. Bedrooms 3
[X] Mobile Home No. Bathrooms 2
☐ Business No. Employees ______
☐ Other ______

Water Supply:
[X] Individual
☐ Public
☐ Community


Comments:/Conditions: (1) GRADE OUT FIELD TERRACE & CALL PRIOR TO INSTALLATION FOR CONSULTATIVE VISIT. DURING LOT CLEARING & GRADING LAST 3 LINES CONTOURS MAY BE GRADED TO SAME CONTOURS AS ABOVE.

Comments:/Conditions: (2) INSTALL LINES ON CONTOURS & MAINTAIN SETBACKS. (3) MAINTAIN MINIMUM 50' FROM WELL & ANY PART OF SYSTEM. (4) OWNER SAYS LOT 6 HAS NO PERMIT ON FILE AT THIS TIME LOT 8 PERMIT IS ATTACHED

INITIAL SITE SKETCH 1"=50'

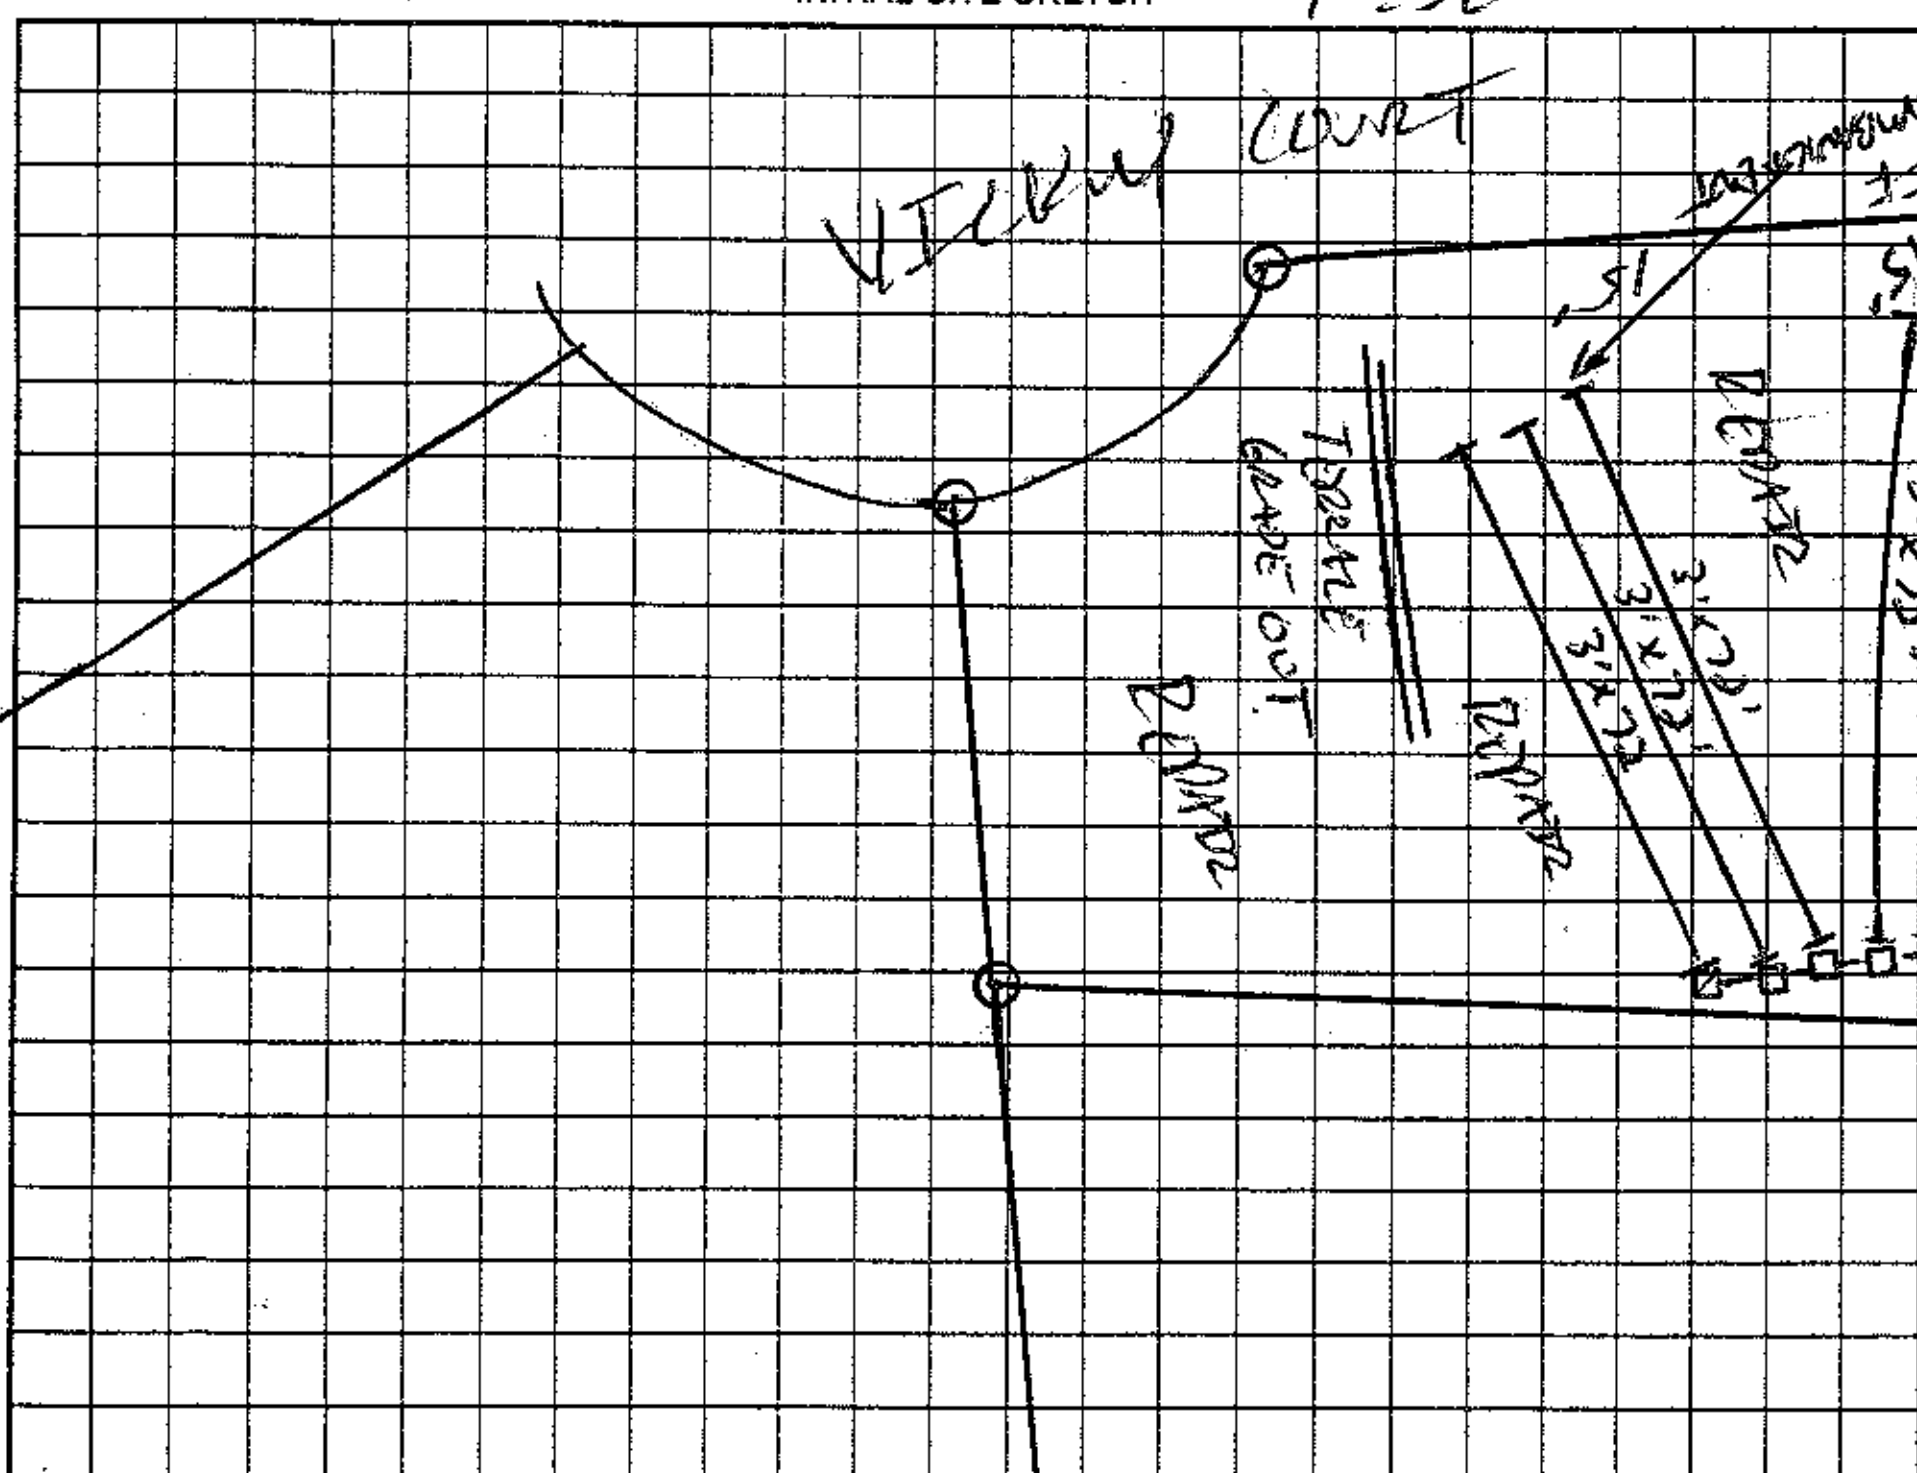

AS BUILT SKETCH

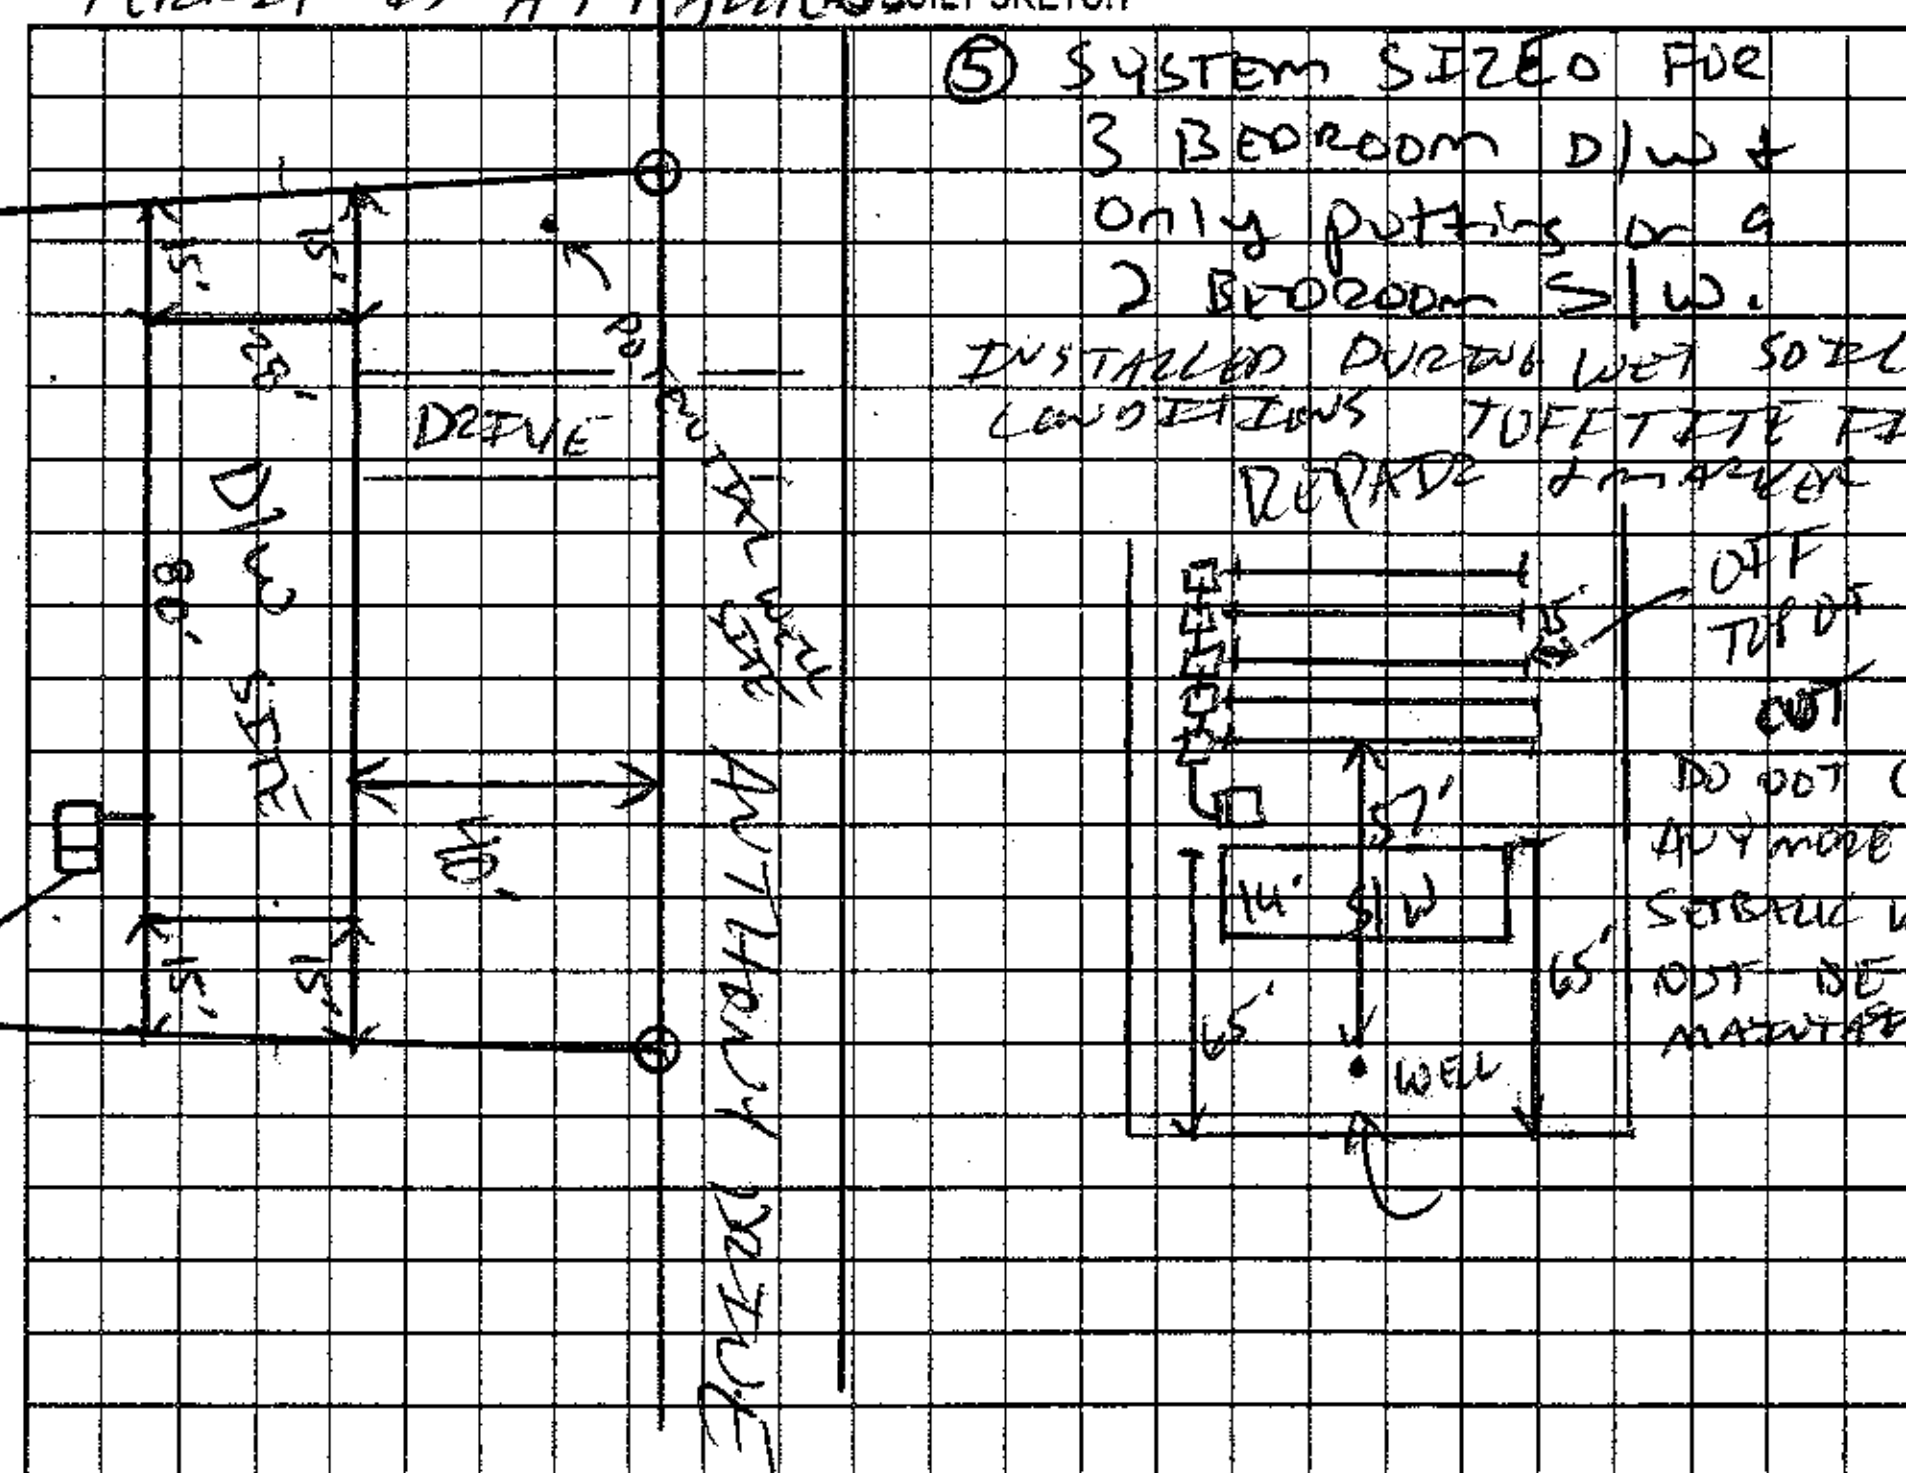

Permit can be suspended or revoked if any false information is supplied toward securing the permit/any unauthorized changes are made to the site/any unauthorized changes are made in the installation of the system. Improvement Permit with plat valid without expiration. Improvement Permit with site plan valid for sixty months. Authorization to Construct is valid for a period equal to that of Improvement Permit – not to exceed sixty months.

Signed: [signature] date 5-10-2004 Installed by: FRYE GRADING

Improvement Permit by: [signature] RS date 5-10-04 Operation Permit by: [signature] RS date 6-21-04

Authorization to Construct by: [signature] RS date 5-10-04 Existing System Inspection by: ______ date ______

HEALTH DEPT. COPY: WHITE OWNER COPY (FINAL): YELLOW OWNER COPY (INITIAL): PINK