IREDELL COUNTY HEALTH DEPARTMENT

STATESVILLE 704-878-5305 (C) MOORESVILLE 704-664-5281

IMPROVEMENT PERMIT / AUTHORIZATION TO CONSTRUCT / OPERATION PERMIT / EXISTING SYSTEM INSPECTION

PERMIT# 106542 PIN# 4711-99-9357-H 4711-98-7524 DATE 6-14-03

OWNER OR CONTRACTOR ANTHONY DAY PHONE: Business Home 704-528-4830

ADDRESS 1633 EUFOLA ROAD STATESVILLE, NC 28677

LOCATION BUFFALO SHOALS ROAD, TL EUFOLA ROAD, TR AMBER LANE, TL AMBRY DR, ON RIGHT AT HIGH SPRINGS CT.

SUBDIVISION ANTHONY DAY EST. BLOCK / SECTION LOT 11 LOT AREA 0.526 ACRE SITE CLASS. PS DESIGN FLOW 360 L.T.A.R. 0.30 GPD/FT²

Septic Tank: 1000 Gallons; STB 1012 Date 7-1-03
Pump Tank: Gallons; PT Date
Pump Make: Model Serial No.
Nitrification Field: No Fields 1 Square Feet 69.90/1200 Linear Feet 300
No Lines FIVE Trench Width 36" Max Trench Bottom Depth 36" Gravel Depth N/A

☑ New System ☐ Repair System Type: I, II, (III), IV, V, VI
System Description: 25% REDUCTION, GRAVITY
Repair System Description: 25% REDUCTION, PUMP
Maintenance Agreement Required: ☐ Yes ☑ No


☐ House/Mod. Home No. Bedrooms 3
☑ Mobile Home No. Bathrooms 2
☐ Business No. Employees
☐ Other FUTURE 3BR HOUSE
☐ Slab ☑ Crawl Space ☐ Basement w/plumbing ☐ Basement wo/plumbing

Water Supply: ☑ Individual ☐ Public ☐ Community WELL


Comments:/Conditions: ① INSTALL SEPTIC TANK AT GRADE OR HIGHER TO OBTAIN GRAVITY-FED SYSTEM ② KEEP SYSTEM REPAIR AREA MAXIMUM FEASIBLE DISTANCE (70') FROM WELL ③ 25% REDUCTION SYSTEM

Comments:/Conditions: SEPTIC TANK WITH MARKER INSTALLED USING "THITTE" FILTER

INITIAL SITE SKETCH

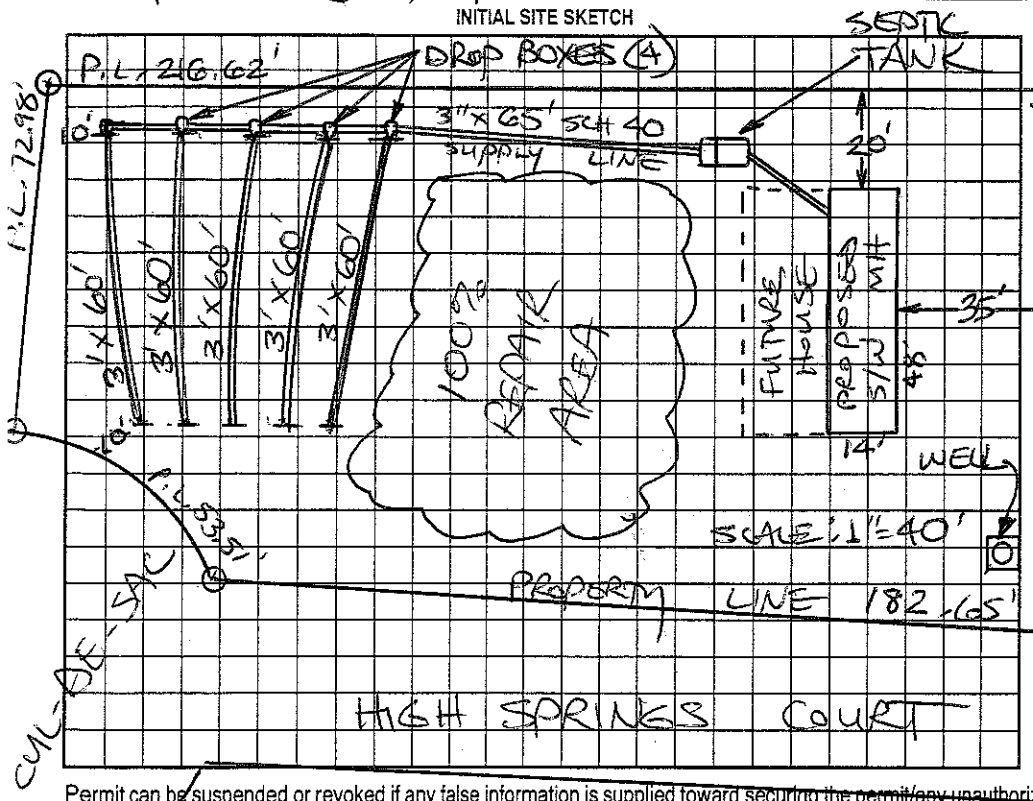

AS BUILT SKETCH

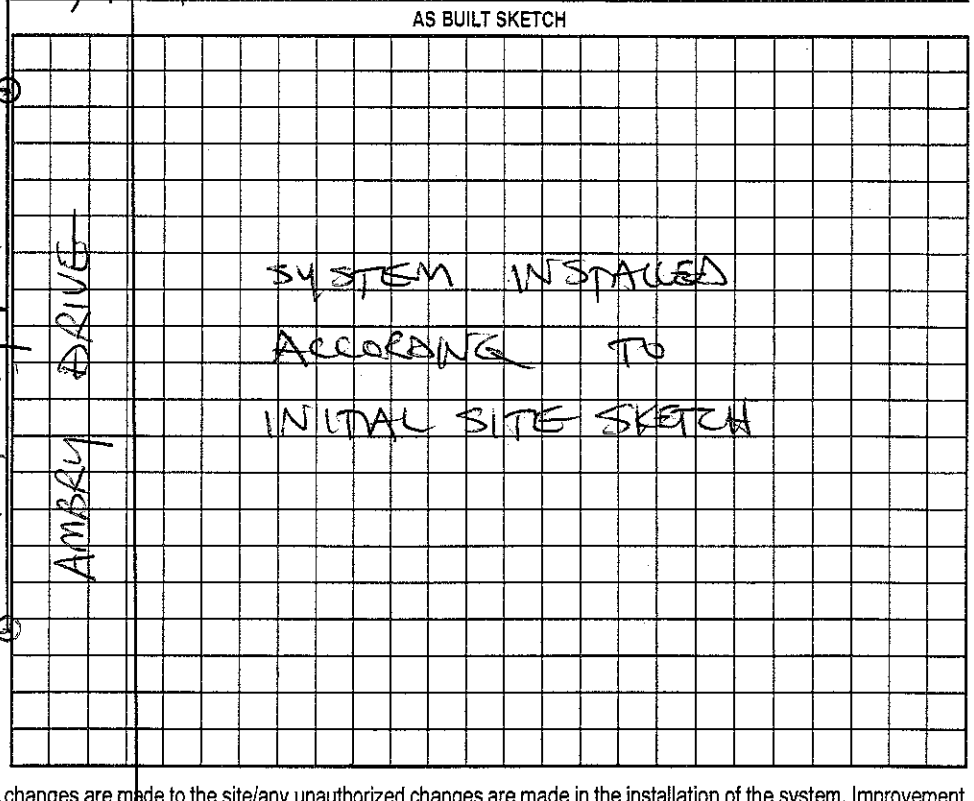

Permit can be suspended or revoked if any false information is supplied toward securing the permit/any unauthorized changes are made to the site/any unauthorized changes are made in the installation of the system. Improvement Permit with plat valid without expiration. Improvement Permit with site plan valid for sixty months. Authorization to Construct is valid for a period equal to that of Improvement Permit – not to exceed sixty months.

Signed: date 7-25-03 Installed by: CRAIG THOMPSON

Improvement Permit by: STEVE HEDRICK date 6-14-03 Operation Permit by: STEVE HEDRICK date 12-12-03

Authorization to Construct by: STEVE HEDRICK date 6-14-03 Existing System Inspection by: date

HEALTH DEPT. COPY: WHITE OWNER COPY (FINAL): YELLOW OWNER COPY (INITIAL): PINK