THIS PERMIT VOIDS PREVIOUS ISSUED 7-16-99

IREDELL COUNTY HEALTH DEPARTMENT

STATESVILLE 704-878-5305 MOORESVILLE 704-664-5281

IMPROVEMENT PERMIT / AUTHORIZATION TO CONSTRUCT / OPERATION PERMIT / EXISTING SYSTEM INSPECTION

PERMIT# 082137 PIN# 4711 97 9357 DATE 7-11-01

OWNER OR CONTRACTOR ANTHONY, DAN PHONE: Business _____ Home (704) 528-9830

ADDRESS 1633 EUFOLA ROAD, STATESVILLE NC 28677

LOCATION BUFFALO SHOALS ROAD, TL EUFOLA ROAD, TR AMBER LANE, TL ANTHONY DR, 2ND on (R)

SUBDIVISION ANTHONY DAN ESTATES BLOCK / SECTION _____ LOT 12 LOT AREA 0.514 ACRE SITE CLASS PS DESIGN FLOW 360 L.T.A.R. 0.30 GPD/FT²

Septic Tank: 1000 Gallons: STB 312 Date 6-27-99
Pump Tank: EXISTING Gallons: PT _____ Date _____
Pump Make: _____ Model _____ Serial No _____
Nitrification Field: No Fields 1 Square Feet EQ. TO/200 Linear Feet 300+
No Lines FIVE Trench Width 36" Max Trench Bottom Depth 46" Gravel Depth N/A

☑ New System ☐ Repair System Type: I. II. III. IV. V.
System Description: 25% REDUCTION GRAVITY
Repair System Description: 25% REDUCTION GRAVITY
Maintenance Agreement Required ☐ Yes ☑ No
☐ Slab ☐ Crawl Space ☐ Basement w/plumbing ☐ Basement wo/plumbing


☐ House/Mod. Home ☑ Mobile Home ☐ Business ☐ Other
No. Bedrooms 3 No. Bathrooms 2 No. Employees _____

Water Supply: ☑ Individual ☐ Public ☐ Community WELL


Comments/Conditions: ABANDON EXISTING DRAINLINES, INSTALL NEW 25% REDUCTION SYSTEM USING FIFTY (50) CHAMBERS OR THIRTY (30) HDS SECTIONS

Comments/Conditions: SEPTIC TANK WITH RISERS INSTALLED USING "POLYLOK" FILTER

INITIAL SITE SKETCH

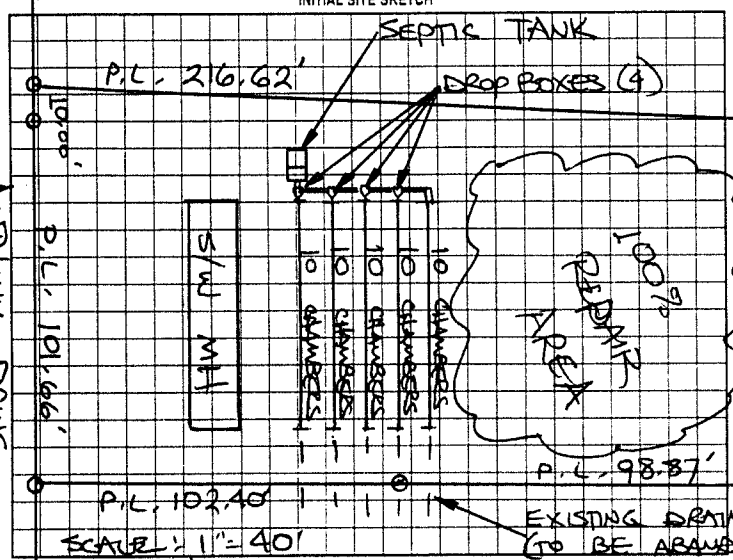

AS BUILT SKETCH

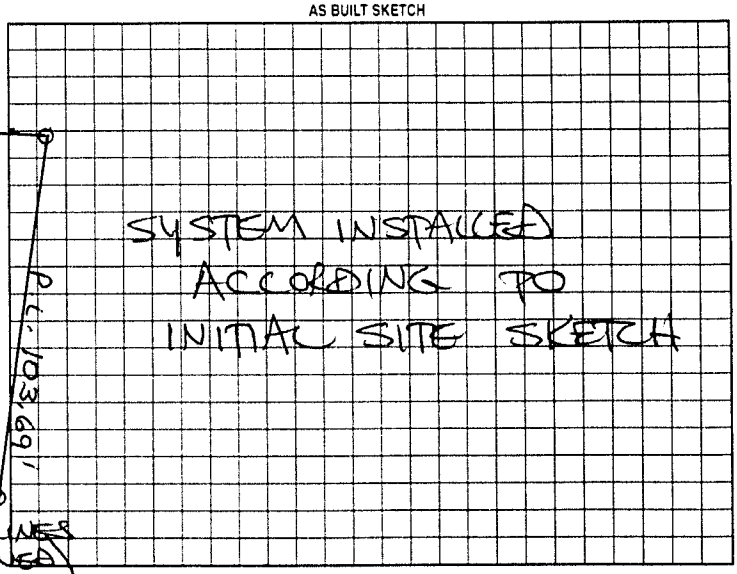

Permit can be suspended or revoked if any false information is supplied toward securing the permit/any unauthorized changes are made to the site/any unauthorized changes are made in the installation of the system. Improvement Permit with plat valid ~~without expiration~~. Improvement Permit with site plan valid for sixty months. Authorization to Construct is valid for a period equal to that of Improvement Permit – not to exceed sixty months.

Signed: [signature] date 7-11-01 Installed by: BARRY SIGMON

Improvement Permit by: STEVE HENDRICK date 7-11-01 Operation Permit by: STEVE HENDRICK date 7-12-01

Authorization to Construct by: STEVE HENDRICK date 7-11-01 Existing System Inspection by: _____ date _____

HEALTH DEPT COPY WHITE OWNER COPY (FINAL) YELLOW OWNER COPY (INITIAL) PINK