# IREDELL COUNTY HEALTH DEPARTMENT

STATESVILLE 704-878-5305 MOORESVILLE 704-664-5281

## IMPROVEMENT PERMIT / AUTHORIZATION TO CONSTRUCT / OPERATION PERMIT / EXISTING SYSTEM INSPECTION

PERMIT# 71364 PIN# 4712030281 DATE 1-20-98

OWNER OR CONTRACTOR April Stinson PHONE: Business Home 528 9449

ADDRESS 1018 Charlotte Hwy Troutman N.C.

LOCATION Buffalo Shoals Rd / Turn Eufola Rd TL Carriage Ln TR Lewis Ridge at end

SUBDIVISION BLOCK / SECTION LOT LOT AREA 1.75 acres SITE CLASS. PS DESIGN FLOW 360 L.T.A.R. .3

Septic Tank: 1000 Gallons; STB 1012 Date 12-15-97
Pump Tank: Gallons; PT Date
Pump Make: Model Serial No.
Nitrification Field: No Fields 1 Square Feet 900 Linear Feet 300
No Lines 4 Trench Width 36" Max Trench Bottom Depth 36" Gravel Depth N/A

☑ New System ☐ Repair System Type: I, II, III, IV, V, VI
System Description: Gravity Chambers
Repair System Description:
Maintenance Agreement Required: ☐ Yes ☑ No

☐ House/Mod. Home No. Bedrooms 3
☑ Mobile Home No. Bathrooms 2
☑ Business No. Employees
☐ Other


☐ Slab ☑ Crawl Space ☐ Basement w/plumbing ☐ Basement wo/plumbing

Water Supply: ☑ Individual ☐ Public ☐ Community


Comments:/Conditions:
Well must be drilled with steel or PVC casing
House must be placed as high on lot as possible with Zoning Set backs

Comments:/Conditions:
* Tank switched to opposite side of house
keep well 50 ft from system

INITIAL SITE SKETCH

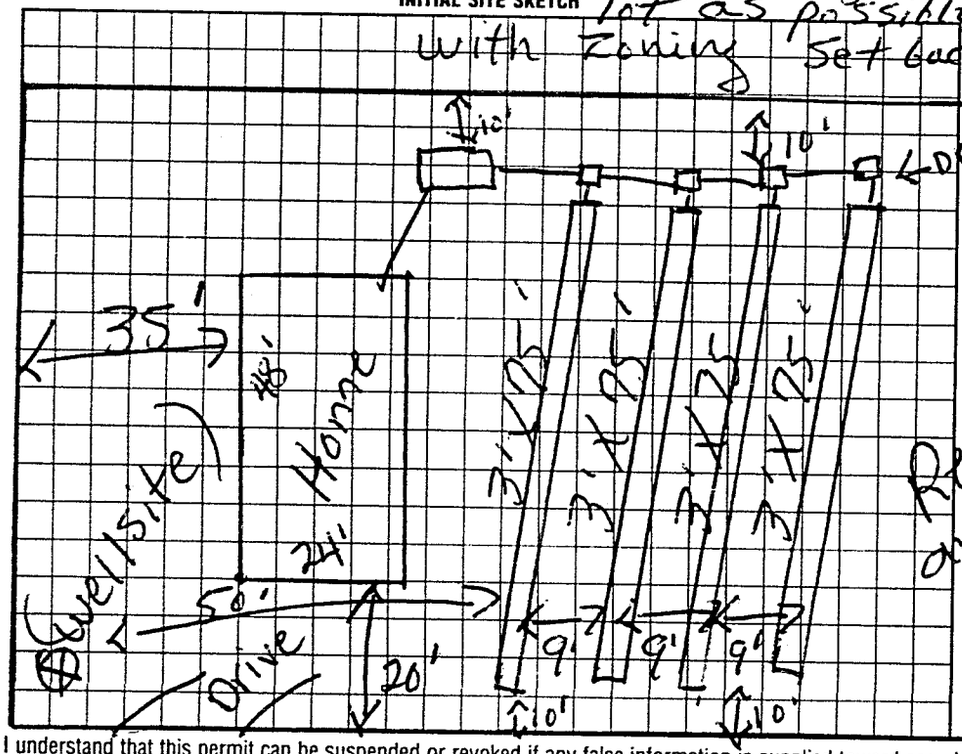


AS BUILT SKETCH

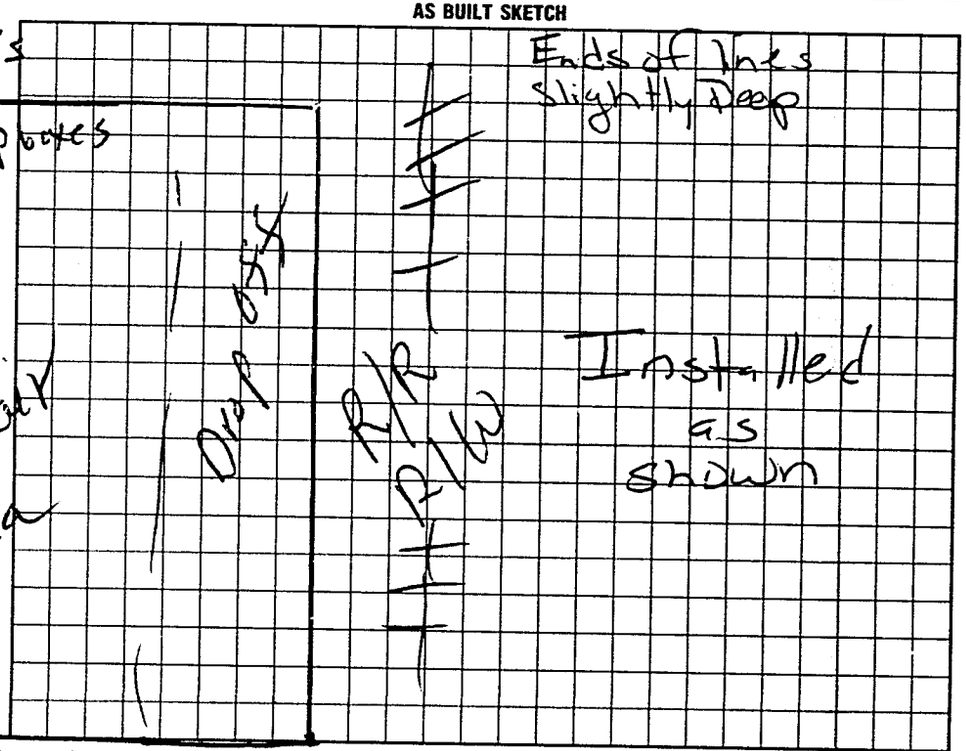


I understand that this permit can be suspended or revoked if any false information is supplied toward securing the permit/any unauthorized changes are made to the site/any unauthorized changes are made in the installation of the system. Improvement Permit with plat valid without expiration. Improvement Permit with site plan valid for sixty months. Authorization to Construct is valid for a period equal to that of Improvement Permit – not to exceed sixty months.

Signed: Dennis Gallhe date

Improvement Permit by: L. C. Moore date 1-20-98

Authorization to Construct by: L. C. Moore date 1-20-98

Installed by: A-1 Backhoe

Operation Permit by: Mark C. Ott RS date 3-25-98

Existing System Inspection by: date

HEALTH DEPT. COPY: WHITE INSPECTION COPY (FINAL): GREEN OWNER COPY (FINAL): YELLOW INSPECTION COPY (INITIAL): PINK OWNER COPY (INITIAL): GOLD

Lewis Ridge R/W