IREDELL COUNTY HEALTH DEPARTMENT

STATESVILLE 704-878-5305 MOORESVILLE 704-664-5281

IMPROVEMENT PERMIT / AUTHORIZATION TO CONSTRUCT / OPERATION PERMIT / EXISTING SYSTEM INSPECTION

PERMIT# 82002 PIN# 4772 03 2963 DATE Jan 11, 2000

OWNER OR CONTRACTOR Samuel Plott James Adam Plott PHONE: Business _____ Home 873 7419

ADDRESS 127 Suzanne Ln Statesville NC

LOCATION Eutola Rd Across From Chalet - Eutola Rd 976 Eutola Rd.

SUBDIVISION _____ BLOCK / SECTION _____ LOT _____ LOT AREA 3.5 Ac. SITE CLASS PS DESIGN FLOW 240 L.T.A.R. .25

Septic Tank: 1000 Gallons; STB 1012 Date 1-21-00 ☑ New System ☐ Repair System Type: I (1) III, IV, V, VI

Pump Tank: _____ Gallons; PT _____ Date _____ System Description: Conv Gravity Shallow

Pump Make: _____ Model _____ Serial No. _____ Repair System Description: 50% Reduction

Nitrification Field: No Fields 1 Square Feet 960 Linear Feet 320 Maintenance Agreement Required. ☐ Yes ☑ No

No Lines 3 Trench Width 36" Max Trench Bottom Dep~~th~~ 18" Gravel Depth 12" ☐ Slab ☑ Crawl Space ☐ Basement w/plumbing ☐ Basement wo/plumbing

☐ House/Mod. Home No. Bedrooms 2

☑ Mobile Home SW No. Bathrooms _____

☐ Business No. Employees _____

☐ Other _____


Water Supply: ☑ Individual ☐ Public ☐ Community

WELL


Comments./Conditions: (1) Locate Septic Tank After Home is set up Keep Tank 100 ft from bored well. Locate New well 50 ft min. (2) Use Distribution Box w/ ☑ Speed Levels. + Flow divider Tee for last Two Lines (3) Make sure lower Line is 100 ft from Creek edge (4) Shallow System 18" deep (5) Landscape to provide surface drainage

Comments./Conditions:

INITIAL SITE SKETCH

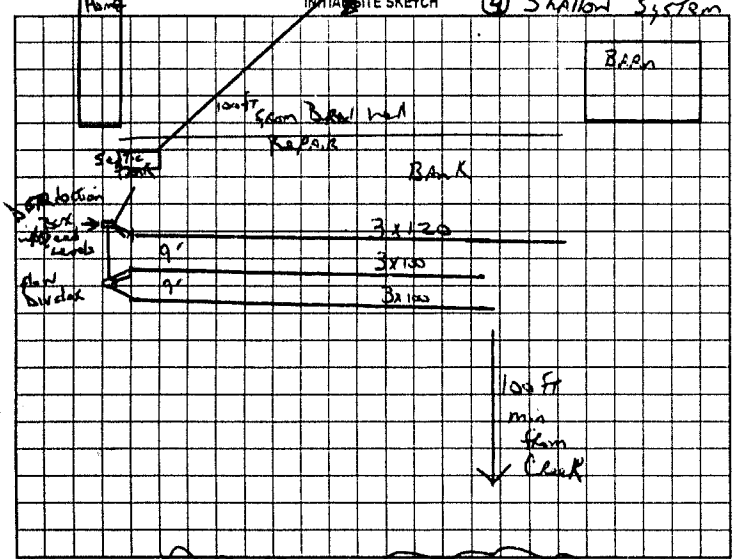

AS-BUILT SKETCH

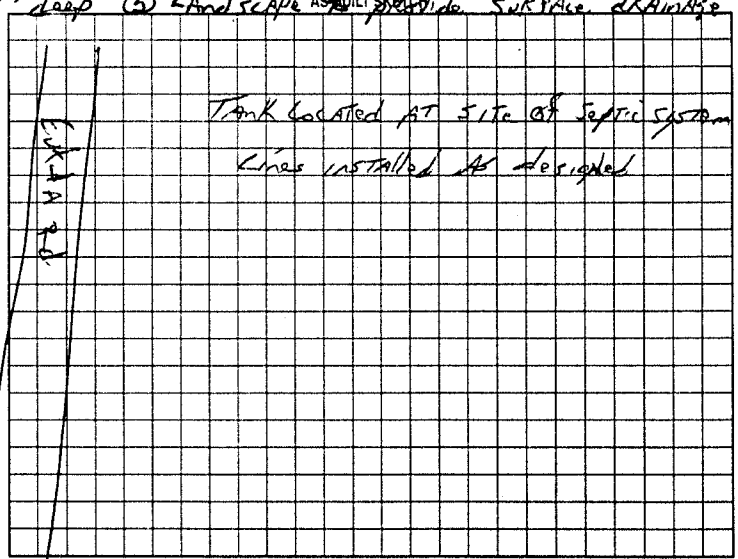

Permit can be suspended or revoked if any false information is supplied toward securing the permit/any unauthorized changes are made to the site/any unauthorized changes are made in the installation of the system. Improvement Permit with plat valid without expiration. Improvement Permit with site plan valid for sixty months. Authorization to Construct is valid for a period equal to that of Improvement Permit – not to exceed sixty months.

Signed: Samuel E. Plott date 1-11-2000 Installed by: Al Backhoe

Improvement Permit by: J.C Potter date 1.11.2000 Operation Permit by: J.C Potter date May 30, 2000

Authorization to Construct by: J.C Potter date Jan 11 2000 Existing System Inspection by: _____ date _____

HEALTH DEPT. COPY. WHITE OWNER COPY (FINAL). YELLOW OWNER COPY (INITIAL). PINK