IREDELL COUNTY HEALTH DEPARTMENT

STATESVILLE 704-878-5305 MOORESVILLE 704-664-5281

IMPROVEMENT PERMIT / AUTHORIZATION TO CONSTRUCT / OPERATION PERMIT / EXISTING SYSTEM INSPECTION

PERMIT# 88962 PIN# 4712042358 DATE May 17 2000

OWNER OR CONTRACTOR Christine E. Plott PHONE: Business _____ Home 872 7835

ADDRESS 600 Celeste Eufola Rd Statesville

LOCATION Old NC 21 Rd (T) Celeste Eufola follow To End At Eufola Rd Lot is on Right up hill Facing Celeste Eufola

SUBDIVISION Alma Plott BLOCK / SECTION _____ LOT 1 LOT AREA 2.17Ac SITE CLASS PS DESIGN FLOW 360 L.T.A.R. .3

Septic Tank: 1000 Gallons: STB 1012 Date 1-21-00
Pump Tank: _____ Gallons: PT _____ Date _____
Pump Make: _____ Model _____ Serial No. _____
Nitrification Field: No Fields 1 Square Feet 1200 Linear Feet 400
No Lines 4 Trench Width 36" Max Trench Bottom Depth 36"

☑ New System ☐ Repair System Type: I. (II) III. IV. V. VI
System Description: Conventional Gravity
Repair System Description: Same Possible Reduction
Maintenance Agreement Required: ☐ Yes ☑ No

☑ House/Mod. Home No. Bedrooms 3
☐ Mobile Home No. Bathrooms 2
☐ Business No. Employees ____
☐ Other _____


Water Supply: ☑ Individual ☐ Public ☐ Community
well

☐ Slab ☒ Crawl Space ☐ Basement w/plumbing ☐ Basement wo/plumbing

Comments:/Conditions: Install on Contour
Smooth Field Terraces May use Distribution Box or Flow dividers
Locate well 100Ft or MAX Feasible Distance From Septic System (50 ft Min)
Not To Scale

Comments:/Conditions

POTENTIAL INITIAL SITE SKETCH

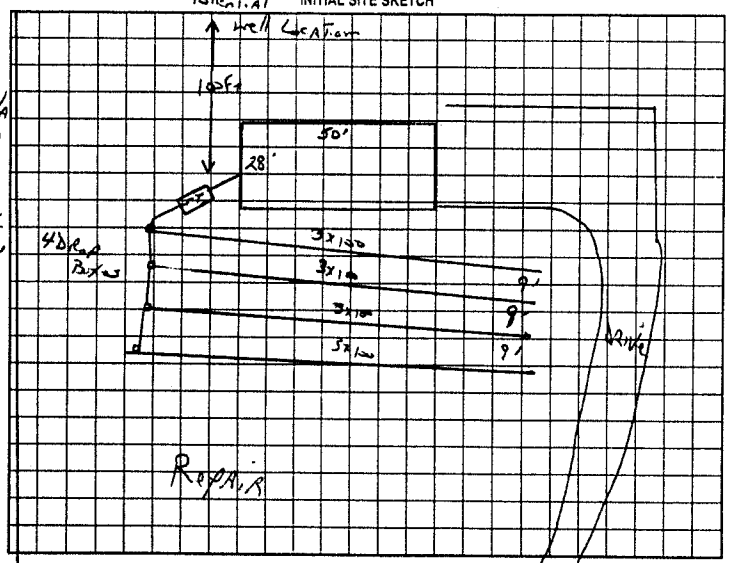

AS BUILT SKETCH

System Installed As Designed

Permit can be suspended or revoked if any false information is supplied toward securing the permit/any unauthorized changes are made to the site/any unauthorized changes are made in the installation of the system. Improvement Permit with plat valid without expiration. Improvement Permit with site plan valid for sixty months. Authorization to Construct is valid for a period equal to that of Improvement Permit – not to exceed sixty months.

Signed: Carl Plott date 5-17-00 Installed by: M Brigham

Improvement Permit by: J C Potter date May 17 2000 Operation Permit by: J C Potter date May 30 2000

Authorization to Construct by: J C Potter date May 17 2000 Existing System Inspection by: _____ date _____

HEALTH DEPT. COPY WHITE OWNER COPY (FINAL) YELLOW OWNER COPY (INITIAL) PINK