IREDELL COUNTY HEALTH DEPARTMENT

STATESVILLE 704-878-5305 (CV) MOORESVILLE 704-664-5281

IMPROVEMENT PERMIT / AUTHORIZATION TO CONSTRUCT / OPERATION PERMIT / EXISTING SYSTEM INSPECTION

(V)

PERMIT# 109724 PIN# 4712-05-4637 DATE 11-20-02

OWNER OR CONTRACTOR FLEETWOOD HOMES OF STATESVILLE PHONE Business 704-872-0179 Home

ADDRESS 1270 NORTHSIDE DRIVE, STATESVILLE NC 28677

LOCATION US 70 WEST, TL OLD MTN. RD, TR LEWIS FERRY RD, TL EUFOLA RD, 0.8 MILE ON LEFT, 1000' BACK

SUBDIVISION BLOCK / SECTION LOT LOT AREA 6.65 Acres SITE CLASS PS DESIGN FLOW 600 L.T.A.R. 0.35 GPD/FT²

Septic Tank: 1500 Gallons: STB 1011 Date 2-1-02
Pump Tank: Gallons: PT Date
Pump Make: Model Serial No.
Nitrification Field: No Fields 1 Square Feet 1710+ Linear Feet 570+
No Lines SIX Trench Width 36" Max Trench Bottom Depth 36" Gravel Depth 12"

☑ New System ☐ Repair System Type: I, II, III, IV, V, VI
System Description: CONVENTIONAL, GRAVITY
Repair System Description: 50% REDUCTION PUMP
Maintenance Agreement Required: ☐ Yes ☑ No LOW PRESS


☐ House/Mod. Home ☑ Mobile Home ☐ Business ☐ Other
No. Bedrooms 5 No. Bathrooms 2 No. Employees
☐ Slab ☑ Crawl Space ☐ Basement w/plumbing ☐ Basement wo/plumbing

Water Supply: ☑ Individual ☐ Public ☐ Community WELL


Comments/Conditions: PARTIAL REPAIR AREA; UNSUITABLE TOPOGRAPHY

Comments/Conditions: SEPTIC TANK WITH MARKER INSTALLED USING "TUFTITE" FILTER

INITIAL SITE SKETCH

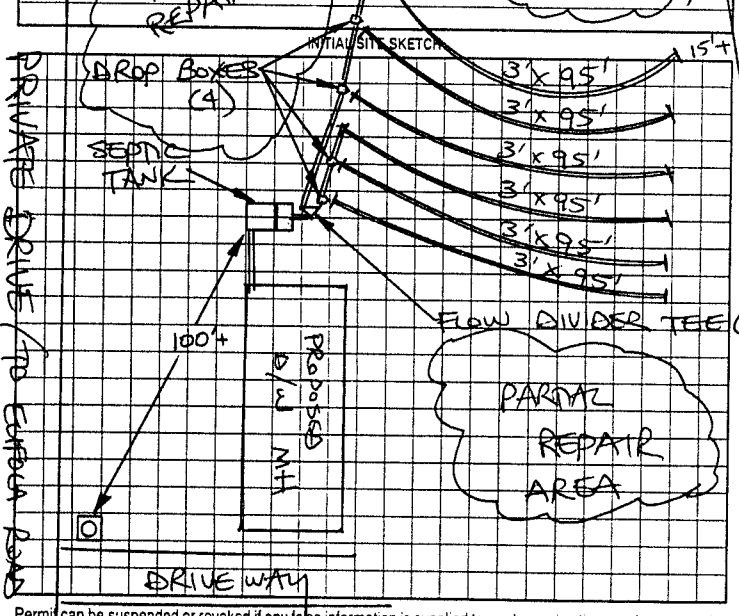

AS BUILT SKETCH

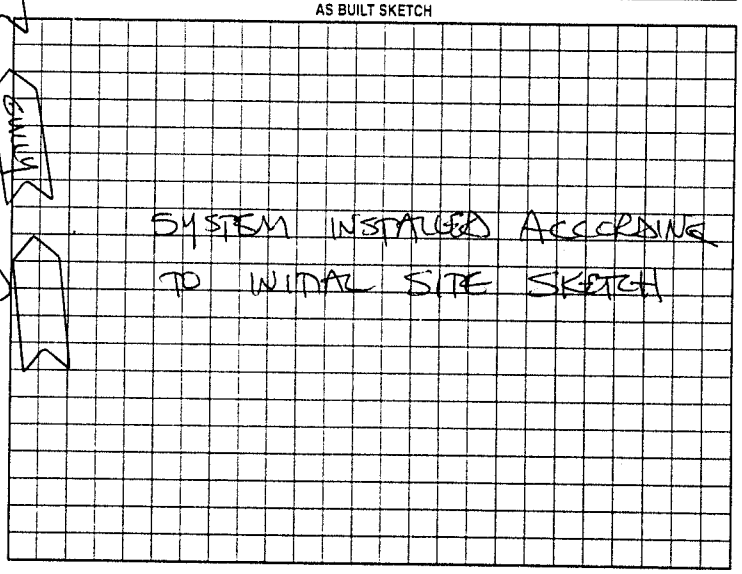

Permit can be suspended or revoked if any false information is supplied toward securing the permit/any unauthorized changes are made to the site/any unauthorized changes are made in the installation of the system. Improvement Permit with plat valid without expiration. Improvement Permit with site plan valid for sixty months. Authorization to Construct is valid for a period equal to that of Improvement Permit – not to exceed sixty months

Signed: date 11/20/02 Installed by CRAIG THOMPSON

Improvement Permit by: STEVE HEDRICK date 11-20-02 Operation Permit by: STEVE HEDRICK date 11-20-02

Authorization to Construct by: STEVE HEDRICK date 11-20-02 Existing System Inspection by: date

HEALTH DEPT COPY: WHITE OWNER COPY (FINAL): YELLOW OWNER COPY (INITIAL): PINK