IREDELL COUNTY HEALTH DEPARTMENT

STATESVILLE 704-878-5305 MOORESVILLE 704-664-5281

IMPROVEMENT PERMIT / CERTIFICATE OF COMPLETION / OPERATION PERMIT / EXISTING SYSTEM INSPECTION

PROPERTY DESCRIPTION NO. 66172 DATE 5-7-97 TAX MAP NO. 4712.09.2456 Watershed: ☐ Yes ☐ No

OWNER OR CONTRACTOR Kelly Harris PHONE: Business Home 704 802 1469

ADDRESS 198 Pinehill Acres Drive

LOCATION Old Mocksville Rd Turn Lewis Ferry Rd To Pinehill Acre Rd at end

SUBDIVISION Harris Property BLOCK / SECTION LOT 2 LOT AREA 2.017 acres SITE CLASS. PS DESIGN FLOW 360 L.T.A.R. 1.3

Septic Tank: 1000 Gallons; STB 794 Date 4-24-97

Pump Tank: Gallons; PT Date

Pump Make: Model Serial No.

Nitrification Field: No Fields 1 Square Feet 1200 Linear Feet 400

No Lines 4 Trench Width 36" Max Trench Bottom Depth 36" Gravel Depth 12"

☑ New System ☐ Repair System Type: I, II, III, IV, V, VI

System Description: Conv. Gravity

Repair System Description:

Maintenance Agreement Required: ☐ Yes ☑ No

☐ House/Mod. Home No. Bedrooms 3

☑ Mobile Home No. Bathrooms 2

☐ Business No. Employees

☐ Other


☐ Slab ☑ Crawl Space ☐ Basement w/plumbing ☐ Basement w/o plumbing

Water Supply: ☐ Individual ☐ Community ☑ Public


Comments:

Comments:

INITIAL SITE SKETCH

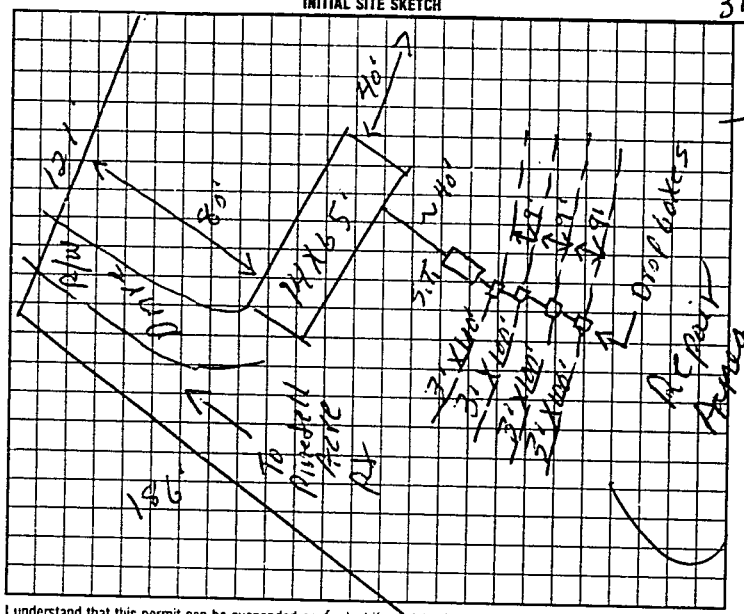

AS BUILT SKETCH

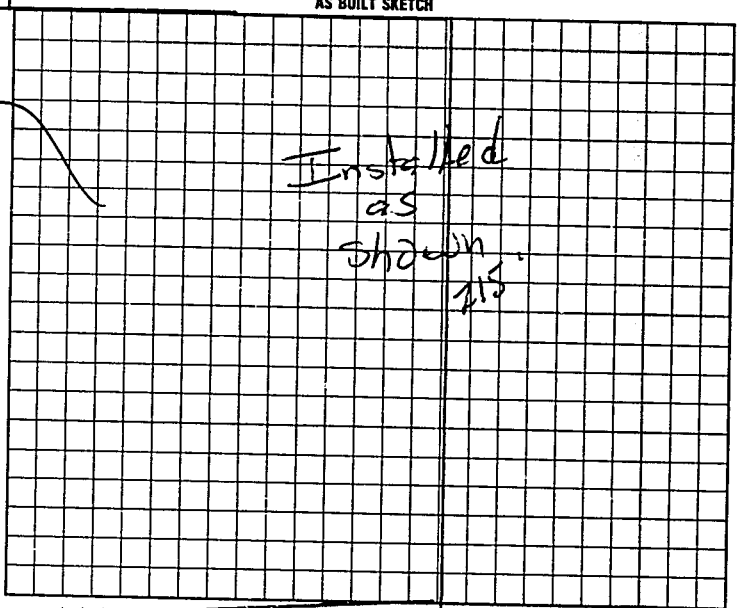

I understand that this permit can be suspended or revoked if any false information is supplied toward securing the permit/any unauthorized changes are made to the site/any unauthorized changes are made in the installation of the system. Improvement Permit is valid for 60 months from date of issuance.

Signed: Kelly Harris

Improvement Permit by: C. Moore date 5-7-97

~~Existing System Inspection by:~~ C. Moore date 5-7-97

HEALTH DEPT. COPY: WHITE INSPECTION COPY (FINAL): GREEN OWNER COPY (FINAL): YELLOW INSPECTION COPY (INITIAL): PINK OWNER COPY (INITIAL): GOLD

Installed by: James Hudler

Certificate of Completion by: date

Operation Permit by: Mark C Ort RS date 6-16-97

To Const.

Authorization to Const. EXPIRED 60 MOS From issue