JAN. 1, 1989 0:10

IREDELL COUNTY HEALTH DEPARTMENT STATESVILLE 704-878-5305 MOORESVILLE 704-664-6281

IMPROVEMENT PERMIT / CERTIFICATE OF COMPLETION / OPERATION PERMIT / EXISTING SYSTEM INSPECTION

PROPERTY DESCRIPTION NO. 66172 DATE 5-2-97 TAX MAP NO. 4712092456 Watershed: ☐ Yes ☐ No

OWNER OR CONTRACTOR Kelly Harris PHONE: Business Home 704 902 1469

ADDRESS 198 Pinehill Acres Drive

LOCATION Old North Rd Turn Lewis Ferry Rd To Pinehill Acres Rd on Rt

SUBDIVISION Harris Property BLOCK / SECTION LOT 2 LOT AREA 2.017 acres SITE CLASS PS DESIGN FLOW 360 L.T.A.R. .13

Septic Tank 1000 Gallons, STB 774 Date 4-21-97 | ☐ New System ☐ Repair System Type (I, II, III, IV, V, VI) | ☐ Residential Home No. Bedrooms 3 | Water Supply: ☐ Individual ☐ Community ☐ Public

Pump Tank ____ Gallons, PT ____ Date ____ | System Description Conv. Gravity | ☐ Mobile Home No. Bathrooms 2

Pump Make ____ Model ____ Serial No. ____ | Repair System Description ____ | ☐ Business No. Employees ____


Medication Pmk. No Fields 4 Square Feet 1200 Lineal Feet 460 | Maintenance Agreement Required ☐ Yes ☐ No | ☐ Other ____

No Lines 4 Trench Width 3' Max Trench Bottom Depth 36" L. Gravel Depth 12" | ☐ Slab ☐ Crawl Space ☐ Basement w/plumbing ☐ Basement w/o plumbing


Comments

Comments

INITIAL SITE SKETCH

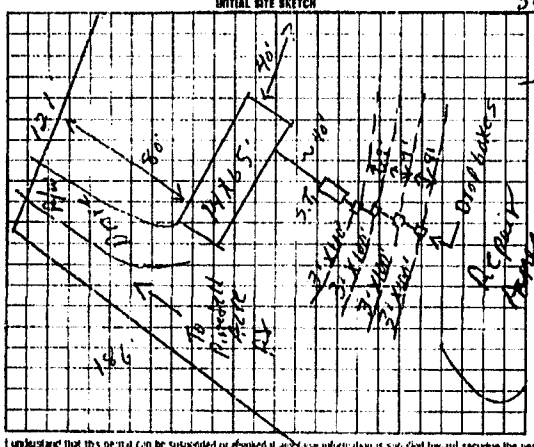

AS BUILT SKETCH

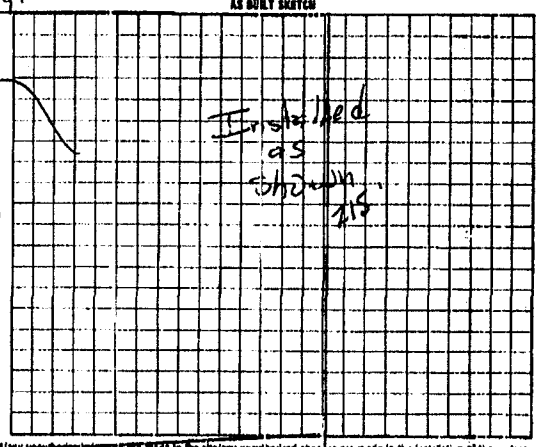

I understand that this permit can be suspended or revoked if any false information is supplied toward securing the permit, unauthorized changes are made to the site/any unauthorized changes are made in the installation of the system. Improvement Permit is valid for 60 months from date of issuance

Signed T Bailey for

Improvement Permit by T. C. Moore date 5-17-94

Certificate of Completion by ____ Date

Operation Permit by Mary C. Ott RS date 6-16-97

Installed by James Hudler

to collect. Authorization to collect. EXPIRES 20 MOS FROM ISSUE