300

IREDELL COUNTY HEALTH DEPARTMENT

STATESVILLE 704-878-5305 @ MOORESVILLE 704-664-5281

IMPROVEMENT PERMIT / AUTHORIZATION TO CONSTRUCT / OPERATION PERMIT / EXISTING SYSTEM INSPECTION

PERMIT # 141765 PIN # 4712 24 7958 DATE April 22, 2010

OWNER or APPLICANT Jonathan McFelland PHONE: Business 704 902 5293 Home:

OWNER or APPLICANT ADDRESS 449 Calhoun Rd, Stony Pt. 28678

LOCATION / DIRECTIONS 223 Atwell Drive I40 W T2 old Mtn Rd. TR Celeste Eufola TL Eufola TL Atwell Dr. At End

SUBDIVISION Eufola Farms BLOCK / SECTION LOT # 24 LOT AREA 3.29 Ac DESIGN FLOW 360gpd L.T.A.R. .025

Septic Tank 1000 Gallons: STB 160 Date 6-10-10

Pump Tank Gallons: P T Date

Pump Make Model Serial #

Nitrification Field No Fields 1 No Lines 4 Linear Feet 360

Trench Width 36" Max. Trench Bottom Depth 36" Gravel Depth NA

☒ New System ☐ Repair ☐ Expansion System Type I II III IV V VI

System Description: Gravity 25% Reduction / Accepted

Repair System Description: Gravity 25% Reduction / Accepted

Maintenance Agreement Required ☐ YES ☒ NO

☒ GRAVITY ☐ PRESSURE

☒ Residence No. Bedrooms 3

☐ Business No. Persons

☐ Other No. Employees

☐ Slab ☐ Crawl Space


☒ Basement w/plumbing ☐ Basement w/o plumbing

Water Supply: ☐ Private ☒ Public ☐ Community


Comments / Conditions: In floor grinder pump to be used to lift sewage to MAIN floor plumbing. Exit main floor plumbing without 6" of existing grade at left front house corner.

Comments / Conditions

INITIAL SITE SKETCH

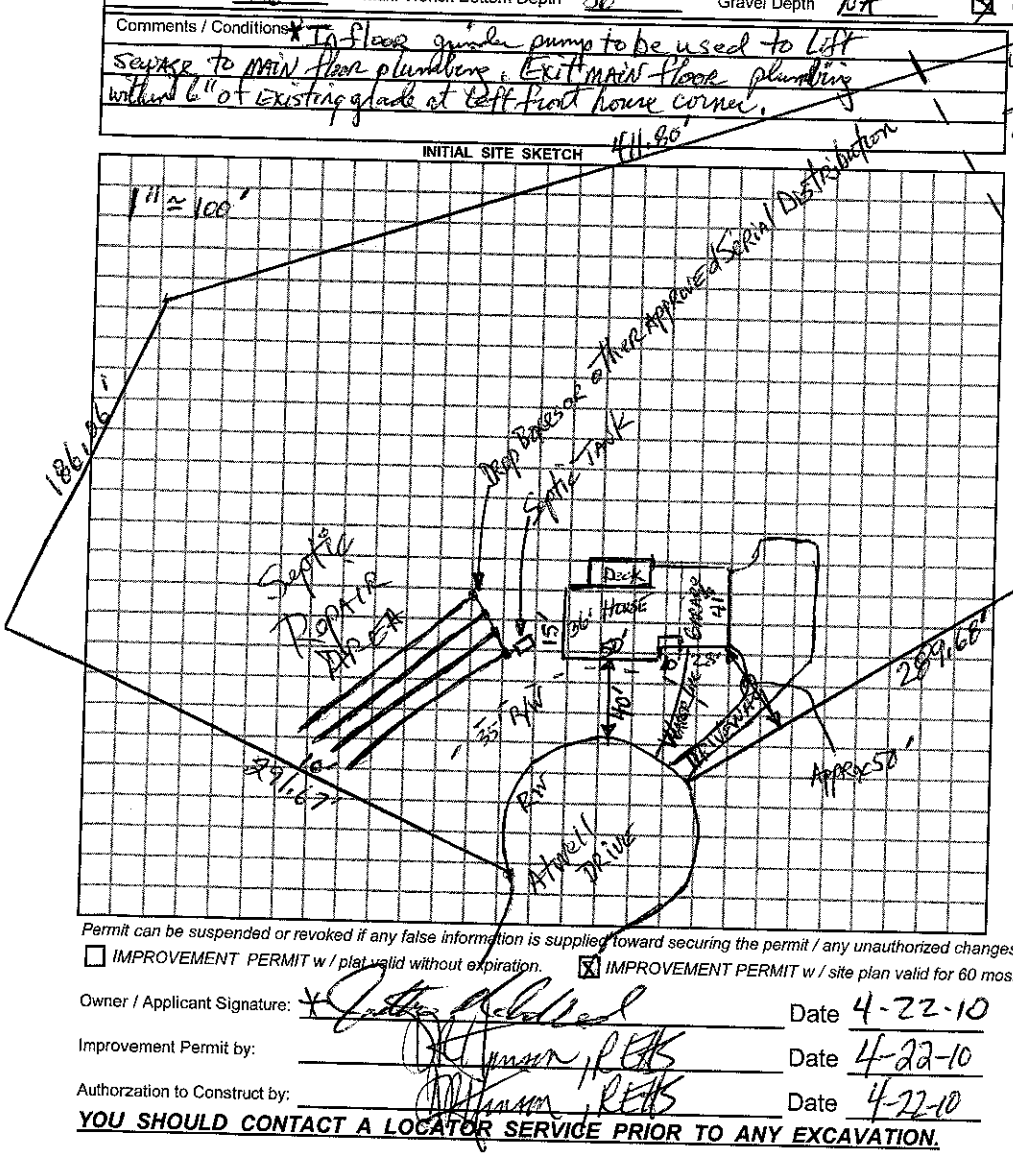

AS BUILT SKETCH

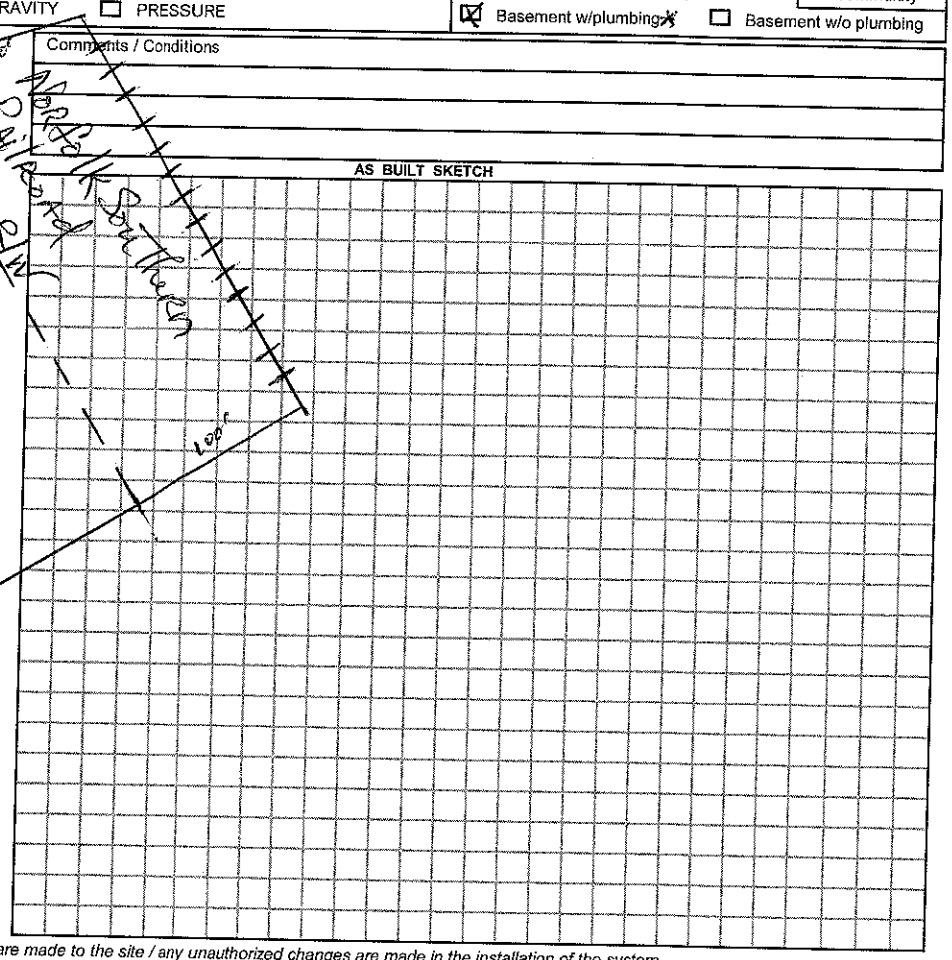

Permit can be suspended or revoked if any false information is supplied toward securing the permit / any unauthorized changes are made to the site / any unauthorized changes are made in the installation of the system.

☐ *IMPROVEMENT PERMIT w / plat valid without expiration.* ☒ *IMPROVEMENT PERMIT w / site plan valid for 60 mos.* ☒ *AUTHORIZATION TO CONSTRUCT valid for period equal to IMPROVEMENT PERMIT-not to exceed 60 mo.*

Owner / Applicant Signature: Jonathan McFelland Date 4-22-10

Improvement Permit by: Jennifer Reeks Date 4-22-10

Authorization to Construct by: Jennifer Reeks Date 4-22-10

YOU SHOULD CONTACT A LOCATOR SERVICE PRIOR TO ANY EXCAVATION.

Installed by: Derrick Barnes

Operation Permit by: James Date: 8-31-10

Existing System Inspected by: Date:

WHITE COPY Environmental Health YELLOW COPY (Final) Owner / Applicant PINK COPY (Initial) Owner / Applicant